

REMONUMENTATION

FEB 22 1996

LIBER 2 PAGE 72

RECEIVED FOR RECORD

COMMISSION

LAND CORNER RECORDATION CERTIFICATE
Filing Requirement of Act 74, Mich. P.A. 1970

95 DEC -6 PM 2:49

For corners in
Sanilac
(County)

Located In:

Corner Code #

- 1. Public Land Survey T 10N R 16E E - 5
- T _____ R _____
- T _____ R _____
- T _____ R _____
- 2. Property Controlling S _____ T _____ R _____
- in Section S _____ T _____ R _____
- 3. Miscellaneous S _____ T _____ R _____
- Property in Sec. S _____ T _____ R _____

LIBER NO. 2 PAGE NO. 72
ESTHER LEE
REGISTER OF DEEDS
SANILAC CO., MICHIGAN

Register of Deeds Stamp & File Number

- 4. Lot No. _____, Recorded Plat _____
- 5. Private Claims _____

John A Milletics, in a field survey on Oct 13, 1995, do hereby certify that under requirements of P.A. 74, Michigan P.A. of 1970, the corner points mentioned in lines 1 and 2 above were in conformance with regulations and rules therefore as required in the current manual of survey instructions of the United States Department of the Interior, Bureau of Land Management or by a decree of a Court of Law and/or that the corner points mentioned in lines 3, 4 and 5 above were in conformance with the rules of the Michigan Board of Land Surveyors or by a Decree of a Court of Law; established, re-established, monumented, re-monumented, recovered, found as expressed below:

A	B	C	D	E	F	G	H	I	J	K	L
2	6	5	4	3	2	1					
3											
4	7	8	9	10	11	12					
5											
6	18	17	16	15	14	13					
7											
8	19	20	21	22	23	24					
9											
10	30	29	28	27	26	25					
11											
12	31	32	33	34	35	36					
13											

NOTE: Not more than 4 corners, all in the same town and range, may be recorded on this certificate.

A. Description of original monument and accessories and/or subsequent restoration:

- E - 5
- GLO Notes
- Set Post at 80.00 Chains
- Beech 10 S77½W 20
- Sugar 11 N82E 26
- Act 74 Form None
- Act 132 Form None
- Unrecorded survey Dated Oct 90 , May 95
- No record in Old Survey Liber

B. Description of corner evidence found and/or method applied in restoring or reestablishing corner:


- E - 5
- SE Cor Section 8 T10N-R16E
- Found 5/8" Iron Bar in Pavement

Approved Peer Board Meeting

Dec 6, 1995 gm

C. Description of monument for corner and accessories established to perpetuate locating the position of the corner:

- E - 5
- SE Cor Section 8 T10N-R16E
- Monu Box
- N45W 74.9 to nail in a Power Pole
- N45E 67.4 to nail in a Tele Pole
- S45E 41.65, to a stop sign
- S30°W 52.6 to a cable post sign

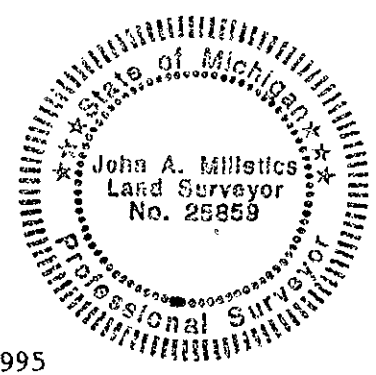

Signed by John A Milletics

Date Nov 23, 1995

Surveyor's Michigan License No. 25859