REMONUMENTATION

FEB 2 2 1996

COMMISSION

LIBER 2 PAGE 71

RECEIVED FOR RECORD

95 DEC -6 PM 2:49

LIBER NO. 2 PAGE NO. 71

ESTHER LEE
REGISTER OF DEEDS
SANILAC CO., MICHIGAN

LAND CORNER RECORDATION CERTIFICATE

Filing Requirement of Act 74, Mich. P.A. 1970

For corners in Sanilac (County)

	Located In:	Corner Code ##
1. Public Land Survey	T 10N R 16E	F - 5 G - 5
	T ___ R ___	
	T ___ R ___	
	T ___ R ___	
2. Property Controlling	S ___ T ___ R ___	
in Section	S ___ T ___ R ___	
3. Miscellaneous	S ___ T ___ R ___	
Property in Sec.	S ___ T ___ R ___	

Register of Deeds Stamp & File Number

4. Lot No. _____ , Recorded Plat _____
5. Private Claims _____

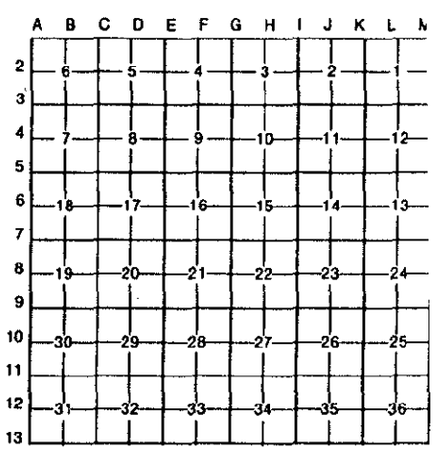

John A Milletics, in a field survey on Oct 13, 19 95, do hereby certify that under requirements of P.A. 74, Michigan P.A. of 1970, the corner points mentioned in lines 1 and 2 above were in conformance with regulations and rules therefore as required in the current manual of survey instructions of the United States Department of the Interior, Bureau of Land Management or by a decree of a Court of Law and/or that the corner points mentioned in lines 3, 4 and 5 above were in conformance with the rules of the Michigan Board of Land Surveyors or by a Decree of a Court of Law; established, re-established, monumented, re-monumented, recovered, found as expressed below:

NOTE: Not more than 4 corners, all in the same town and range, may be recorded on this certificate.

A. Description of original monument and accessories and/or subsequent restoration:

F - 5
GLO NOtes Set Post at 40.15 Chains
Hemlock 30 N20W 10
Beech 12 S43E 28½
Act 74 Form None
Act 132 From None
Unrecorded Survey Dated Oct 1990

G - 5
GLO Notes Set Post at 80.00 Chains
Pine 18 S65W 1
Pine 22 N65E 1
Act 74 Form None
Act 132 Form None
Unrecorded Surveys Dated Oct 1990, Aug 1992. June 19

B. Description of corner evidence found and/or method applied in restoring or reestablishing corner:

F - 5
S 1/4 Cor Section 9 T10N-R16E
Found P.K. Nail in Black top equal distance between SE and SW Cor 2648.8'

G - 5
SE Cor Section 9 T10N-R16E
Found 1" in Blacktop Road Surface

Approved Peer Board Meeting
Dec 6, 1995 JM

Description of monument for corner and accessories established to perpetuate locating the position of the corner:

F - 5
S 1/4 Cor Section 9 T10N-R16E
Monu Box
South 55.15 to a nail in a Fence Post
South 60.10 to a nail in a 24" Poplar
North 49.65 to a nail in a Fence Post
N60°W 113.7 to a nail in a Power Pole

G - 5
SE Cor Section 9 T10N-R16E
Monu Box
N40°E 62.0 to a nail in a Power Pole
S45°W 62.3 to a nail in a Anchor Pole
S45°E 41.50 to s Stop Sign
West 2648.80 to the S 1/4 Cor

State of Michigan
John A. Milletics
Land Surveyor
No. 25859
Professional Surveyor

Signed by John A. Milletics Date NOV 23, 1995

Surveyor's Michigan License No. 25859

FORM APPROVED BY MICHIGAN STATE BOARD OF LAND SURVEYORS, JAN. 28, 1971
REVISED MAY 14, 1975
REVISED JAN., 1983