

FEB 22 1996

LIBER

2 PAGE 70

RECEIVED FOR RECORD

COMMISSION LAND CORNER RECORDATION CERTIFICATE  
Filing Requirement of Act 74, Mich. P.A. 1970

95 DEC -6 PM 2:49  
LIBER NO. 2 PAGE NO 70  
ESTHER LEE  
REGISTER OF DEEDS  
SANILAC CO. MICHIGAN

For corners in  
Sanilac

(County)

Located In:

Corner Code #

- 1. Public Land Survey      T 10N R 16E      H - 5 I - 5
- T        R        \_\_\_\_\_
- T        R        \_\_\_\_\_
- T        R        \_\_\_\_\_
- 2. Property Controlling    S        T        R        \_\_\_\_\_
- in Section                S        T        R        \_\_\_\_\_
- 3. Miscellaneous            S        T        R        \_\_\_\_\_
- Property in Sec.         S        T        R        \_\_\_\_\_

Register of Deeds Stamp & File Number

- 4. Lot No. \_\_\_\_\_, Recorded Plat \_\_\_\_\_
- 5. Private Claims \_\_\_\_\_

	A	B	C	D	E	F	G	H	I	J	K	L	M
2	6		5		4		3		2				
3													
4	7		8		9		10		11				
5													
6	18		17		16		15		14				
7													
8	19		20		21		22		23				
9													
10	30		29		28		27		26				
11													
12	31		32		33		34		35				
13													

John A Millettics, in a field survey on Oct 13, 1995, do hereby certify that under requirements of P.A. 74, Michigan P.A. of 1970, the corner points mentioned in lines 1 and 2 above were in conformance with regulations and rules therefore as required in the current manual of survey instructions of the United States Department of the Interior, Bureau of Land Management or by a decree of a Court of Law and/or that the corner points mentioned in lines 3, 4 and 5 above were in conformance with the rules of the Michigan Board of Land Surveyors or by a Decree of a Court of Law; established, re-established, monumented, re-monumented, recovered, found as expressed below:

NOTE: Not more than 4 corners, all in the same town and range, may be recorded on this certificate.

A. Description of original monument and accessories and/or subsequent restoration:

- |  |                                    |
|--|------------------------------------|
| H - 5                                  | I - 5                              |
| GLO Notes Set 1/4 Post at 39.88 Chains | GLO Notes Set Poat at 80 Chains    |
| Hemlock 6 S23E 35                      | Sugar 22 S36E 25                   |
| Ironwood 4 N73W 7                      | Sugar 17 N29W 41                   |
| Act 74 None                            | Act 74 None                        |
| Act 132 None                           | Act 132 None                       |
| Unrecorded Surveys None Found          | Unrecorded Surveys Dated June 1985 |

B. Description of corner evidence found and/or method applied in restoring or reestablishing corner:


- |                                 |                                       |
|---------------------------------|---------------------------------------|
| H - 5                           | I - 5                                 |
| S 1/4 Cor Section 10 T10N-R16E  | SE Cor Section 10 T10N-R16E           |
| Found 5/8" Iron Bar in Pavement | Found P.K. Nail over iron in Pavement |

Approved Peer Board Meeting

DEC 6, 1995 *JM*

C. Description of monument for corner and accessories established to perpetuate locating the position of the corner:

- |  |                                      |
|--|--------------------------------------|
| H - 5                                  | I - 5                                |
| S 1/4 Cor Section 10 T10N-R16E         | SE Cor Section 10 T10N-R16E          |
| Monu Box                               | Monu Box                             |
| South 56.20' to a nail in a Power Pole | S45°W 69.2 to a nail in a Power Pole |
| N05°E 56.30' to a nail in a 6" Apple   | S40°E 44.9 to a Stop Sign            |
| N40°E 62.20' to a nail in a Fence Post | S70°E 94.3 to a Road Sign            |
| North 50.00' to a 1/2" Iron Bar        | N70°E 93.3 to a Road Sign            |
|  | N70°W 43.1 to a Stop Sign            |

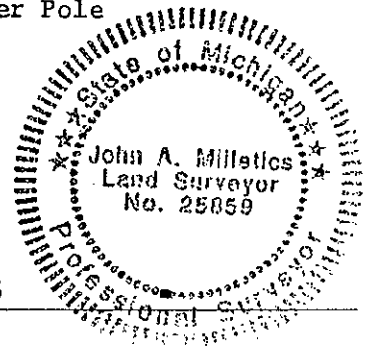

Signed by *John A. Millettics*

Date Nov 23, 1995

Surveyor's Michigan License No. 35859