

FEB 22 1996

LIBER

2 PAGE 70

RECEIVED FOR RECORD

COMMISSION LAND CORNER RECORDATION CERTIFICATE
Filing Requirement of Act 74, Mich. P.A. 1970

95 DEC -6 PM 2:49
LIBER NO. 2 PAGE NO. 70
ESTHER LEE
REGISTER OF DEEDS
SANILAC CO., MICHIGAN

For corners in Sanilac (County) Located In: Corner Code #

1. Public Land Survey	T 10N R 16E	H - 5 I - 5
	T R	
	T R	
	T R	
2. Property Controlling in Section	S T R	
	S T R	
3. Miscellaneous Property in Sec.	S T R	
	S T R	

Register of Deeds Stamp & File Number

4. Lot No. _____, Recorded Plat _____
5. Private Claims _____

A	B	C	D	E	F	G	H	I	J	K	L
2	6	5	4	3	2	1					
3											
4	7	8	9	10	11	12					
5											
6	18	17	16	15	14	13					
7											
8	19	20	21	22	23	24					
9											
10	30	29	28	27	26	25					
11											
12	31	32	33	34	35	36					
13											

John A Milletics, in a field survey on Oct 13, 1995, do hereby certify that under requirements of P.A. 74, Michigan P.A. of 1970, the corner points mentioned in lines 1 and 2 above were in conformance with regulations and rules therefore as required in the current manual of survey instructions of the United States Department of the Interior, Bureau of Land Management or by a decree of a Court of Law and/or that the corner points mentioned in lines 3, 4 and 5 above were in conformance with the rules of the Michigan Board of Land Surveyors or by a Decree of a Court of Law; established, re-established, monumented, re-monumented, recovered, found as expressed below:

NOTE: Not more than 4 corners, all in the same town and range, may be recorded on this certificate.

A. Description of original monument and accessories and/or subsequent restoration:

H - 5	I - 5
GLO Notes Set 1/4 Post at 39.88 Chains	GLO Notes Set Post at 80 Chains
Hemlock 6 S23E 35	Sugar 22 S36E 25
Ironwood 4 N73W 7	Sugar 17 N29W 41
Act 74 None	Act 74 None
Act 132 None	Act 132 None
Unrecorded Surveys None Found	Unrecorded Surveys Dated June 1985

3. Description of corner evidence found and/or method applied in restoring or reestablishing corner:


H - 5	I - 5
S 1/4 Cor Section 10 T10N-R16E	SE Cor Section 10 T10N-R16E
Found 5/8" Iron Bar in Pavement	Found P.K. Nail over iron in Pavement

Approved Peer Board Meeting

DEC 6, 1995 *JM*

C. Description of monument for corner and accessories established to perpetuate locating the position of the corner:

H - 5	I - 5
S 1/4 Cor Section 10 T10N-R16E	SE Cor Section 10 T10N-R16E
Monu Box	Monu Box
South 56.20' to a nail in a Power Pole	S45°W 69.2 to a nail in a Power Pole
N05°E 56.30' to a nail in a 6" Apple	S40°E 44.9 to a Stop Sign
N40°E 62.20' to a nail in a Fence Post	S70°E 94.3 to a Road Sign
North 50.00' to a 1/2" Iron Bar	N70°E 93.3 to a Road Sign
	N70°W 43.1 to a Stop Sign

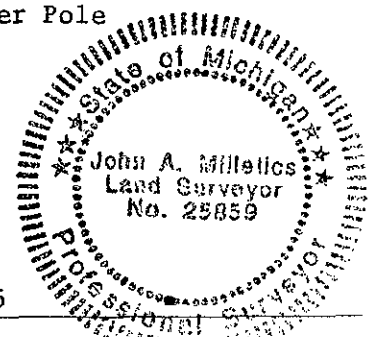

Signed by *John A Milletics* Date Nov. 23, 1995
