LIBER 1 PAGE 456

RECEIVED FOR RECORD
94 AUG 12 PM 2:37
LIBER NO. 1 PAGE NO. 456
ESTHER LEE
REGISTER OF DEEDS
SANILAC CO., MICHIGAN

REMONUMENTATION

LAND CORNER RECORDATION CERTIFICATE
Filing Requirement of Act 74, Mich. P.A. 1970

For corners in
Sanilac (County)

	Located In:	Corner Code #4
1. Public Land Survey	T 10N R 16E	M - 2, M - 3
	T ___ R ___	
	T ___ R ___	
	T ___ R ___	
2. Property Controlling	S ___ T ___ R ___	
in Section	S ___ T ___ R ___	
3. Miscellaneous	S ___ T ___ R ___	
Property in Sec.	S ___ T ___ R ___	

Register of Deeds Stamp & File Number

4. Lot No. _____, Recorded Plat _____
5. Private Claims _____

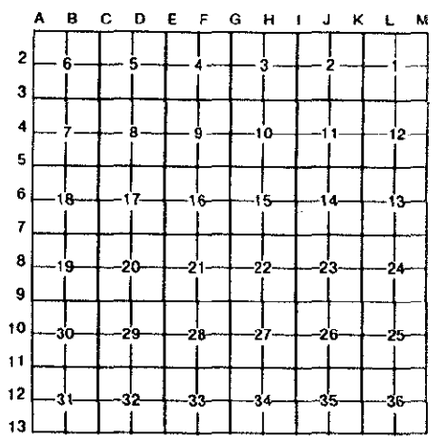

I, John A Milletics, in a field survey on July 16, 19 94, do hereby certify that under requirements of P.A. 74, Michigan P.A. of 1970, the corner points mentioned in lines 1 and 2 above were in conformance with regulations and rules therefore as required in the current manual of survey instructions of the United States Department of the Interior, Bureau of Land Management or by a decree of a Court of Law and/or that the corner points mentioned in lines 3, 4 and 5 above were in conformance with the rules of the Michigan Board of Land Surveyors or by a Decree of a Court of Law; established, re-established, monumented, re-monumented, recovered, found as expressed below:

NOTE: Not more than 4 corners, all in the same town and range, may be recorded on this certificate.

A. Description of original monument and accessories and/or subsequent restoration:
M -2 Found Monu Box in place as per Survey recorded in Liber 3 on Page 3 of the Sanilac County Records.

M - 3 Found Monu Box in place in pavement as shown on the Michigan State Highway Right Way Book on Page 36

Approved Peer Board Meeting
Aug. 9, 1994

B. Description of corner evidence found and/or method applied in restoring or reestablishing corner:
M - 2
E 1/4 Cor Section 1 T10N-R16E
Found Monu Box

M - 3
SE Cor Section 1 T10N-R16E
Found Moun Box

SURVEY & REMONUMENTATION
SEP 07 1994
COMMISSION

C. Description of monument for corner and accessories established to perpetuate locating the position of the corner:

M - 2
E 1/4 Cor Section 1 T10N-R16E
Monu Box
East 48.20 to a nail N side of a Power Pole
N60°W 81.3 to the SE Cor of a Michigan Bell Box
N40°E 92.85 to a nail NW side of a Power Pole
East 31.60 to the N Leg of a Road Sign

M - 3
SE Cor Section 1 T10N-R16E
Monu Box
S45°W 54.30 to a nail SE side of a Tele Pole
N45°W 59.00 to a nail NE side of a Anchor Pole
N45°E 58.85 to a nail SE side of a Tele Pole
S45°E 72.00 to a nail NE side of a Anchor Pole

Signed by John A Milletics Date July 23, 1994
Surveyor's Michigan License No. 25859

FORM APPROVED BY MICHIGAN STATE BOARD OF LAND SURVEYORS, JAN. 28, 1971
REVISED MAY 14, 1975
REVISED JAN., 1983