

SURVEY & REMONUMENTATION

SEP 17 1999

LIBER

2 PAGE 292

RECEIVED FOR RECORD

99 AUG -2 AM 9:08

1999 REMONUMENTATION PROGRAM
LAND CORNER RECORDATION CERTIFICATE
Filing Requirement of Act 74, Mich. P.A. 1970

LIBER NO. 2 PAGE NO. 292
MICHELE VANNORMAN
REGISTER OF DEEDS
SANILAC CO., MICHIGAN

SECTION

For corners in

SANILAC (County)	Located In:	Corner Code #
1. Public Land Survey	T11N R12E	A-2
	T R	
	T R	
	T R	
2. Property Controlling in Section	S T R	
	S T R	
3. Miscellaneous Property in Sec.	S T R	
	S T R	

Register of Deeds Stamp & File Number

- 4. Lot No. _____, Recorded Plat _____
- 5. Private Claims _____

I, John A. Millettics, in a field survey on April 1, 19 99 do hereby state that under requirements of P.A. 74, Michigan P.A. of 1970, the corner points mentioned in lines 1 and 2 above were in conformance with regulations and rules therefore as required in the current manual of survey instructions of the United States Department of the Interior, Bureau of Land Management or by a decree of a Court of Law and for that the corner points mentioned in lines 3, 4 and 5 above were in conformance with the rules of the Michigan Board of Land Surveyors or by a Decree of a Court of Law; established, re-established, monumented, recovered, found as expressed below:

NOTE: Not more than 2 corners, all in the same town and range, may be recorded on this certificate.

	A	B	C	D	E	F	G	H	I	J	K	L	M
1													
2	6		5		4		3		2		1		
3													
4	7		8		9		10		11		12		
5													
6	18		17		16		15		14		13		
7													
8	19		20		21		22		23		24		
9													
10	30		29		28		27		26		25		
11													
12	31		32		33		34		35		36		
13													

- A. Description of original monument and accessories and/or subsequent restoration:
- 1834 (Gov't. Land Office Notes) Harvey Parke, D.S.-Set quarter section post-Elm 10 S36 1/2W 30; Elm 6 N49W 23
 - 1882 (County Surveyor's Record) John A. Teskey, Tuscola County Surveyor-"Established proportionat distance between Sec. Corners" accessories: Stake East 50 links; Stake West 50 links
 - 1987 (Survey-Liber 578, pages 58 and 59) Kenneth D. Dunton, P.S. 23503-Fnd. 1" pipe-S80°W 31.0' MSHD tag in post; S80°E 25.6' MSHD tag in 24" tree; East 2.5' center line N-S gravel
 - 1963 (Michigan State Highway Department witness card) Donald C. Pyle, P.S. 3165-set 1" pipe S77°E 25.66' 27" Maple; S76°W 31.21' T.P.


B. Description of corner evidence found and/or method applied in restoring or reestablishing corner:

- A - 2
- W 1/4 Corner Section 6 T11N-R12E
- Found Standard Concrete Mounment with Brass Cap
- South 2632.15 feet to SW corner Section 6
- North 2594.76 feet to NW corner Section 6
- Accepted as best evidence

APPROVED PEER BOARD MEETING
July 20, 1999

C. Description of monument for corner and accessories established to perpetuate locating the position of the corner:

- Found standard Concrete Monument W/2" Brass cap stamped
- S75°E, 25.68'-T.C. Remon. tag over M.S.H.D tagiin Southwest face of 24" Maple
- S60°E, 56.95'-T.C. Remon. tag in Southwest face of 4" Elm
- S75°W, 31.06'-T.C. Remon. tag over M.S.H.D. tagiin North face of Tele. pole stub
- N08°W, 36.12'-Set 1/2" diameter reinforcing rod

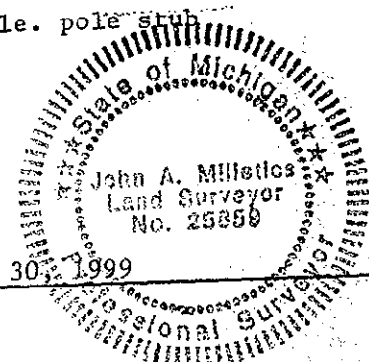

Signed by John A. Millettics
Surveyor's Michigan License No. 25859

Date June 30, 1999