

SURVEY & REMONUMENTATION

SEP 17 1999

LIBER

2 PAGE 293

RECEIVED FOR RECORD

99 AUG -2 AM 9:09

1999 REMONUMENTATION PROGRAM
LAND CORNER RECORDATION CERTIFICATE
 Filing Requirement of Act 74, Mich. P.A. 1970

LIBER NO. 2 PAGE NO. 293
 MICHELE VAHNORMAN
 REGISTER OF DEEDS
 SANILAC CO., MICHIGAN

For corners in **SECTION**

<u>SANILAC</u> (County)	Located In:	Corner Code #
1. Public Land Survey	T <u>11</u> N R <u>12</u> E	<u>A-3</u>
	T ___ R ___	_____
	T ___ R ___	_____
	T ___ R ___	_____
2. Property Controlling in Section	S ___ T ___ R ___	_____
	S ___ T ___ R ___	_____
3. Miscellaneous Property in Sec.	S ___ T ___ R ___	_____
	S ___ T ___ R ___	_____

Register of Deeds Stamp & File Number

4. Lot No. _____, Recorded Plat _____
 5. Private Claims _____

I, John A. Milletics, in a field survey on April 1, 1999 do hereby state that under requirements of P.A. 74, Michigan P.A. of 1970, the corner points mentioned in lines 1 and 2 above were in conformance with regulations and rules therefore as required in the current manual of survey instructions of the United States Department of the Interior, Bureau of Land Management or by a decree of a Court of Law and/or that the corner points mentioned in lines 3, 4 and 5 above were in conformance with the rules of the Michigan Board of Land Surveyors or by a Decree of a Court of Law; established, re-established, monumented, recovered, found as expressed below:

NOTE: Not more than 2 corners, all in the same town and range, may be recorded on this certificate.

A	B	C	D	E	F	G	H	I	J	K	L	M
1												
2	6		5		4		3		2		1	
3												
4	7		8		9		10		11		12	
5												
6	13		17		16		15		14		13	
7												
8	19		20		21		22		23		24	
9												
10	30		29		28		27		26		25	
11												
12	31		32		33		34		35		36	
13												

A. Description of original monument and accessories and/or subsequent restoration:

- 1834 (Gov't. Land Office Notes) Harvey Parke, D.S.-Set post Cor. Sections 1 & 2-Elm 16 N25W 20; Maple 10 S65 1/2 W14
- 1882 (County Surveyor's Record) John A. Teskey, Tuscola County Surveyor-"Identified from Elm 16 N25W 20" Perpetuated corner with Stake-No additional accessories
- 1977 (Land Corner Recordation Certificate) Kenneth D. Dunton, P.S. 23503-Fnd. small pieces of wood post. Set 1/2" re-rod W/Cap RLS 11192. in TP; S40°E 34.85' to Rd. sign post; S50°E 42.35' to S. end of 24" CMP
- ** 1987 (Survey -Liber 578, pages 58 and 59) Kenneth D. Dunton, P.S. 23505-Fnd. 1/2" rod & cap did not re-witness.


B. Description of corner evidence found and/or method applied in restoring or reestablishing corner:

A - 3
 SW Corner Section 6 T11N-R12E
 Found Standard Concrete Monument with Brass Cap
 North 2632.15 to W 1/4 Corner
 South 2659.29 to W 1/4 Corner
 Accepted as best evidence

APPROVED PEER BOARD MEETING
 July 20, 1999

C. Description of monument for corner and accessories established to perpetuate locating the position of the corner:

Found Standard Concrete Monument W/2" Brass Cap
 N40°E, 45.76' T.C. Remon. tag in SE face of Telephone pole stub
 S20°W, 71.90' T.C. Remon. tag in NW face of 4" Forked Ash
 S60°W, 31.55' T.C. Remon. tag in NW face of 10" Poplar
 N80°W, 22.85' T.C. Remon. tag in N face of 4" Ash

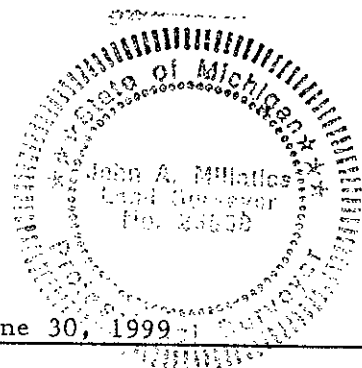

Signed by John A. Milletics
 Surveyor's Michigan License No. 25859

Date June 30, 1999