

SURVEY & REMONUMENTATION

LIBER

2 PAGE 295

RECEIVED FOR RECORD

SEP 17 1999

1999 REMONUMENTATION PROGRAM
LAND CORNER RECORDATION CERTIFICATE
Filing Requirement of Act 74, Mich. P.A. 1970

99 AUG -2 AM 9:09

LIBER NO. 2 PAGE NO. 295
MICHELE VANNORMAN
REGISTER OF DEEDS
SANILAC CO., MICHIGAN

For corners in SECTION

SANILAC (County)	Located In:	Corner Code #
1. Public Land Survey	T <u>11</u> N <u>12</u> E	<u>A-5</u>
	T <u> </u> R <u> </u>	<u> </u>
	T <u> </u> R <u> </u>	<u> </u>
	T <u> </u> R <u> </u>	<u> </u>
2. Property Controlling in Section	S <u> </u> T <u> </u> R <u> </u>	<u> </u>
	S <u> </u> T <u> </u> R <u> </u>	<u> </u>
3. Miscellaneous Property in Sec.	S <u> </u> T <u> </u> R <u> </u>	<u> </u>
	S <u> </u> T <u> </u> R <u> </u>	<u> </u>

Register of Deeds Stamp & File Number

4. Lot No. _____, Recorded Plat _____
5. Private Claims _____

	A	B	C	D	E	F	G	H	I	J	K	L	M
1													
2	6		5		4		3		2		1		
3													
4	7		8		9		10		11		12		
5													
6	10		17		16		15		14		13		
7													
8	19		20		21		22		23		24		
9													
10	30		29		28		27		26		25		
11													
12	31		32		33		34		35		36		
13													

I, John A. Milletics, in a field survey on April 1, 1999 do hereby state that under requirements of P.A. 74, Michigan P.A. of 1970, the corner points mentioned in lines 1 and 2 above were in conformance with regulations and rules therefore as required in the current manual of survey instructions of the United States Department of the Interior, Bureau of Land Management or by a decree of a Court of Law and/or that the corner points mentioned in lines 3, 4 and 5 above were in conformance with the rules of the Michigan Board of Land Surveyors or by a Decree of a Court of Law; established, re-established, monumented, recovered, found as expressed below:

NOTE: Not more than 2 corners, all in the same town and range, may be recorded on this certificate.

A. Description of original monument and accessories and/or subsequent restoration:

- 1834 (Gov't. Land Office Notes) Harvey Parke, D.S.-Set post Cor. Sections 12,13-Hemlock 24 N46W 72½; Beech 8 S45W 27
- 1886 (County Surveyor's Record) John A. Teskey, Tuscola County Surveyor-marked corner with stone No Bearing trees
- 1973 (Survey-Liber 431, page 387) Harold N. Elrich, P.S. 18986-Fnd. nail using "ties" and set ½" iron-N60°E 51.0' Sign Post; S30°W 44.0' Fence Post; S60°W 42.43' U.S.G.S. Monument
- 1973 (Land Corner Recordation Certificate) Harold N. Elrich, P.S. 18986-accessories same as above
- 1974 (Survey-Liber 441, page 291) Bernard Henderson, P.S. 16043-Fnd. ½" iron-accessories same as shown on Elrich's Survey and Land Corner Recordation Certificate.
- 1976 (Land Corner Recordation Certificate) James A. Beck, P.S. 21559-


B. Description of corner evidence found and/or method applied in restoring or reestablishing corner:

A - 5
SW Corner Section 7 T11N-R12E
Found Standard Concrete Monument with Brass Cap
North 2640.21 feet to the W 1/4 Corner
South 2650.48 feet to the W 1/4 Corner
Accepted as best evidence

APPROVED PEER BOARD MEETING
July 20, 1999 *JM*

C. Description of monument for corner and accessories established to perpetuate locating the position of the corner:

Found Standard Concrete Monument W/2" Brass Cap
S85°E, 33.58' Top ½" iron encased in 4" diameter Concrete Cylinder
S65°E, 106.60' T.C. Remon. tag in North face 9" White Birch
N85°W, 33.12' Found ½" iron with cap #25859 in bottom of ditch
N82°W, 43.58' T.C. Remon. tag above found spike in North face of 6" Poplar

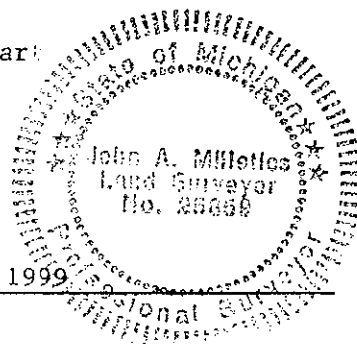

Signed by *John A. Milletics*
Surveyor's Michigan License No. 25859

Date June 30, 1999