

**SURVEY &
REMONUMENTATION**

SEP 17 1999

LIBER

2 PAGE 300

RECEIVED FOR RECORD

99 AUG -2 AM 9:09

SECTION

1999 REMONUMENTATION PROGRAM
LAND CORNER RECORDATION CERTIFICATE
Filing Requirement of Act 74, Mich. P.A. 1970

LIBER NO. 2 PAGE NO. 300
MICHELE VANNORMAN
REGISTER OF DEEDS
SANILAC CO., MICHIGAN

For corners in

SANILAC

(County)

Located In:

Corner Code #

- | | | |
|------------------------------------|----------------|-------|
| 1. Public Land Survey | T11N R12E | A-10 |
| | T___ R___ | _____ |
| | T___ R___ | _____ |
| | T___ R___ | _____ |
| 2. Property Controlling in Section | S___ T___ R___ | _____ |
| | S___ T___ R___ | _____ |
| 3. Miscellaneous Property in Sec. | S___ T___ R___ | _____ |
| | S___ T___ R___ | _____ |

Register of Deeds Stamp & File Number

4. Lot No. _____, Recorded Plat _____
5. Private Claims _____

	A	B	C	D	E	F	G	H	I	J	K	L	M
1													
2	6		5		4		3		2		1		
3													
4	7		8		9		10		11		12		
5													
6	18		17		16		15		14		13		
7													
8	19		20		21		22		23		24		
9													
10	30		29		28		27		26		25		
11													
12	31		32		33		34		35		36		
13													

I, John A. Millettics, in a field survey on April 1, 1999 do hereby state that under requirements of P.A. 74, Michigan P.A. of 1970, the corner points mentioned in lines 1 and 2 above were in conformance with regulations and rules therefore as required in the current manual of survey instructions of the United States Department of the Interior, Bureau of Land Management or by a decree of a Court of Law and/or that the corner points mentioned in lines 3, 4 and 5 above were in conformance with the rules of the Michigan Board of Land Surveyors or by a Decree of a Court of Law; established, re-established, monumented, recovered, found as expressed below:

NOTE: Not more than 2 corners, all in the same town and range, may be recorded on this certificate.

A. Description of original monument and accessories and/or subsequent restoration:

- 1834 (Gov't. Land Office Notes) Harvey Parke, D.S.-set quarter section post-B. Ash 12 S4W 43; Hemlock 10 N34W 43
- 1972 (Survey-Liber 1 of Surveys, page 349) David T. Rowe, P.S. 11192-set "T" Iron-N45°E 15.15' PK nail in 4" Tree; East 33.0' "T" iron; S80°W 30.56' PK nail in Anchor post; West 33.0' "T" iron
- 1972 (Survey-Liber 2 of Surveys, pages 20 & 21) David T. Rowe, P.S. 11192-same marker and accessories as above Survey except distance to "T" iron East shows as 23.0'
- 1972 (Land Corner Recordation Certificate) David T. Rowe, P.S. 11192-Fnd. pieces of wood & Charcoal 1.5'+/-under Rd. Raised with "T" iron. Accessories same as shown in 1972 Survey above-Liber 1 of Surveys, page 349

B. Description of corner evidence found and/or method applied in restoring or reestablishing corner:


A - 10
W 1/4 Corner Section 30 T11N-R12E
Found Standard Concrete Monument with Brass Cap
South 2646.67 feet to the SW Corner Section 30
North 2648.18 feet to the Nw Corner Section 30
Accepted as best evidence

APPROVED PEER BOARD MEETING
July 20, 1999

JM

C. Description of monument for corner and accessories established to perpetuate locating the position of the corner:

Found Standard Concrete Monument W/2" Brass Cap
N65°E, 45.15' T.C. Remon. tag in NW face of 9" Apple Tree
S65°E, 25.60' T.C. Remon. tag in SW face of 2" Ash
S40°W, 17.11' set 5/8" diameter reinforcing rod
N40°W, 14.87' set 5/8" diameter reinforcing rod

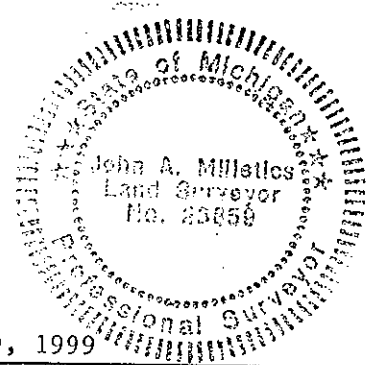

Signed by John A. Millettics

Date June 30, 1999

Surveyor's Michigan License No. 25859