

NOV 19 1993 LAND CORNER RECORDATION CERTIFICATE

COMMISSION FILING REQUIREMENT OF ACT 74, MICH. P.A.1970

FOR CORNERS OF--:	LOCATED IN--:	CORNER CODE NUMBER
1. PUBLIC LAND SURVEY _____	T. <u>11</u> N. S., R. <u>12</u> E. W.	E - 13, <u>F - 13</u>
2. PROPERTY CONTROLLING IN SECTION _____	T. _____ N. S., R. _____ E. W.	_____
3. MISCELLANEOUS PROPERTY IN SECTION _____	T. _____ N. S., R. _____ E. W.	_____
4. LOT NO. _____, RECORDED PLAT _____		
5. PRIVATE CLAIMS _____		

RECEIVED FOR RECORD  
 93 NOV -8 PM 1:39  
 LIBER NO. 1 PAGE NO. 389  
 ESTHER LEE  
 REGISTER OF DEEDS  
 SANILAC CO., MICHIGAN  
 REGISTER OF DEEDS STAMP AND FILING NUMBER

I, John A Milletics, do hereby certify that under requirements of P.A. 74, Michigan P.A. of 1970, the corner points mentioned in lines 1 and 2 above were, in a field survey on Aug 21, 1993, established, re-established, monumented, re-monumented, recovered or restored as expressed below and in conformance with regulations and rules therefore as required in the current manual of survey instructions of the United States Department of the Interior, Bureau of Land Management or by a decree of a court of law. Furthermore, that the corner points mentioned in lines 3, 4 and 5 above were, in a field survey on \_\_\_\_\_, 19\_\_\_\_, found, recovered, restored, established or re-established as expressed below and in conformance with the rules of the Michigan State Board of Registration for Land Surveyors or, by a Decree of a Court of law:

A. Description of original monument and accessories and/or subsequent restoration:

E - 13 Found P.K. nail in blacktop as recorded in Liber 4 Page 415 of the Sanilac County Records.

F - 13 Found R/R Spike in Blacktop as recorded with plat in the SE 1/4 of Section 32

B. Description of corner evidence found and/or method applied in restoring or re-establishing corner:

E - 13  
SW Cor Section 33 T11N-R12E  
Found P.K. nail

F - 13  
S 1/4 Cor Section 33 T11N-R12E  
Found R/R Spike

C. Description of monument for corner and accessories established to perpetuate locating the position of the corner:


E - 13  
SW Cor Section 33 T11N-R12E  
Set Monu Box  
N10°E 78.95' to a nail in a Power Pole  
N45°W 51.55' to a Metal Fence Post  
S20°E 39.90' to a nail ina 24" Maple

F - 13  
S 1/4 Cor Section 33 T11N-R12E  
Set Monu Box  
North 53.85' to a nail in a 18" Locust Tree  
N45°E 87.45' to a nail in a 12" Maple Tree  
2636.36' to the East to the SE Cor Section 33

SIGNED BY John A Milletics DATE Nov 4, 1993  
 SURVEYOR'S MICHIGAN REGISTRATION NO. 25859

FOR STATE AND UNITED STATES AGENCIES:

SIGNED BY \_\_\_\_\_ DATE \_\_\_\_\_  
 APPROVED AND SIGNED BY \_\_\_\_\_ DATE \_\_\_\_\_  
 CHIEF OF SURVEY PARTY  
 MICHIGAN REGISTERED LAND SURVEYOR

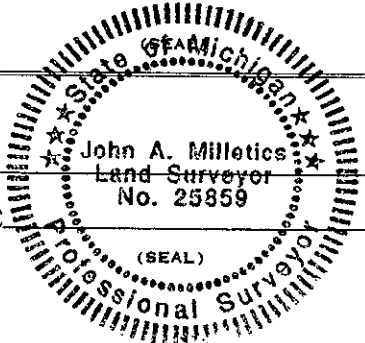

SURVEYOR'S MICHIGAN REGISTRATION NO. \_\_\_\_\_