REMONUMENTATION CORNER

LAND CORNER RECORDATION CERTIFICATE
Filing Requirement of Act 74, Mich. P.A. 1970

LIBER 1 PAGE 394

For corners in

Sanilac (County)

	Located In:	Corner Code #
1. Public Land Survey	T 11N R 12E	J -13, K - 13
	T ___ R ___	
	T ___ R ___	
	T ___ R ___	
2. Property Controlling	S ___ T ___ R ___	
in Section	S ___ T ___ R ___	
3. Miscellaneous	S ___ T ___ R ___	
Property in Sec.	S ___ T ___ R ___	

RECEIVED FOR RECORD
93 DEC 14 PM 3:00
LIBER NO. 1 PAGE NO. 394
ESTHER LEE
REGISTER OF DEEDS
SANILAC CO., MICHIGAN

Register of Deeds Stamp & File Number

4. Lot No. _____, Recorded Plat _____
5. Private Claims _____

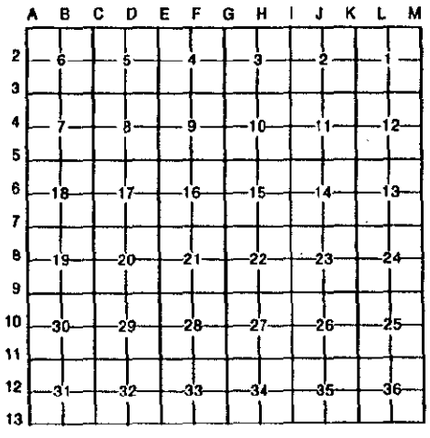

I, John A Milletics, in a field survey on Aug 21, 19 93, do hereby certify that under requirements of P.A. 74, Michigan P.A. of 1970, the corner points mentioned in lines 1 and 2 above were in conformance with regulations and rules therefore as required in the current manual of survey instructions of the United States Department of the Interior, Bureau of Land Management or by a decree of a Court of Law and/or that the corner points mentioned in lines 3, 4 and 5 above were in conformance with the rules of the Michigan Board of Land Surveyors or by a Decree of a Court of Law; established, re-established, monumented, re-monumented, recovered, found as expressed below:

NOTE: Not more than 4 corners, all in the same town and range, may be recorded on this certificate.

A. Description of original monument and accessories and/or subsequent restoration:

J - 13 Found Railroad Spike as recorded in Liber 4 Page 22 of the Sanilac County Records

K - 13 Found Railroad Spike as recorded in Liber 4 Page 22 of the Sanilac County Records

B. Description of corner evidence found and/or method applied in restoring or reestablishing corner:

J - 13
S 1/4 Cor Section 35 T11N-R12E
Found Railroad Spike

K - 13
SE Cor Section 35 T11N-R12E
Found Railroad Spike

SURVEY &
REMONUMENTATION
1993
COMMISSION

C. Description of monument for corner and accessories established to perpetuate locating the position of the corner:

J - 13
S 1/4 Cor Section 35 T11N-R12E
Set Monu Box
North 54.75' to a nail in a Power Pole
N10°E 47.65' to the East End of a 12" CMP
East 2644.09' to the SE Cor Section 35

K - 13
SE Corner Section 35 T11N-R12E
Set Monu Box
N45°W 65.45' to a Nail in a Power Pole
N45°E 74.60' to a Nail in a Power Pole
South 20.28' to the West leg of a Arrow Sign
West 2644.09' to the S. 1/4 Cor Section 35

Signed by John A Milletics Date Dec 13, 1993

Surveyor's Michigan License No. 25859

FORM APPROVED BY MICHIGAN STATE BOARD OF LAND SURVEYORS, JAN. 28, 1971
REVISED MAY 14, 1975
REVISED JAN., 1983