REMONUMENTATION CORNER

LAND CORNER RECORDATION CERTIFICATE
Filing Requirement of Act 74, Mich. P.A. 1970

LIBER 1 PAGE 398

RECEIVED FOR RECORD
93 DEC 15 AM 9:15
LIBER NO. 1 PAGE NO. 398
ESTHER LEE
REGISTER OF DEEDS
SANILAC CO., MICHIGAN

Register of Deeds Stamp & File Number

For corners in

Sanilac (County)

		Located In:	Corner Code ##
1. Public Land Survey		T 11N R 13E	D -13, E - 13
		T ___ R ___	
		T ___ R ___	
		T ___ R ___	Xeg.
2. Property Controlling	S ___	T ___ R ___	
in Section	S ___	T ___ R ___	
3. Miscellaneous	S ___	T ___ R ___	
Property in Sec.	S ___	T ___ R ___	

4. Lot No. _____, Recorded Plat _____
5. Private Claims _____

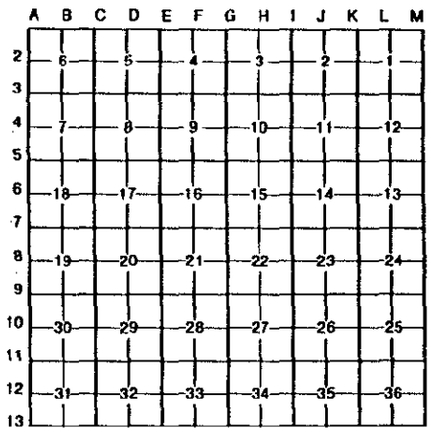

I, John A Milletics, in a field survey on Aug 23, 19 93, do hereby certify that under requirements of P.A. 74, Michigan P.A. of 1970, the corner points mentioned in lines 1 and 2 above were in conformance with regulations and rules therefore as required in the current manual of survey instructions of the United States Department of the Interior, Bureau of Land Management or by a decree of a Court of Law and/or that the corner points mentioned in lines 3, 4 and 5 above were in conformance with the rules of the Michigan Board of Land Surveyors or by a Decree of a Court of Law; established, re-established, monumented, re-monumented, recovered, found as expressed below:

NOTE: Not more than 4 corners, all in the same town and range, may be recorded on this certificate.

A. Description of original monument and accessories and/or subsequent restoration:

D - 13 Found no evidence of original corner in existence

E - 13 Found Moun Box in place as recorded in Liber 3 Page 577 of the Sanilac County Records

B. Description of corner evidence found and/or method applied in restoring or reestablishing corner:

D - 13
S 1/4 Cor Section 32 T11N-R13E
Set corner at a equal distance between the
SE Cor and the SW cor of the Section (2648.84')

E - 13
SE Cor Section 32 T11N-R13E
Found Monu Box

SURVEY &
REMONUMENTATION
1993
COMMISSION

C. Description of monument for corner and accessories established to perpetuate locating the position of the corner:

D - 13
S 1/4 Cor Section 32 T11N-R13E
Set Monu Box
North 62.10' to a nail in a Power Pole
West 5.12' to the N 1/4 Cor Section 4(Monu Box)
N10°W 27.65' to the N. End of a CMP

E - 13
SE Cor Section 32 T11N-R13E
Found Moun Box
West 20.05' to the NE Cor Section 4(Monu Box
S45°E 48.10' to a nail in a Tele Pole
N45°E 66.40' to a nail in a Power Pole

Signed by John A. Milletics Date Dec 14, 1993

Surveyor's Michigan License No. 25859

FORM APPROVED BY MICHIGAN STATE BOARD OF LAND SURVEYORS, JAN. 28, 1971
REVISED MAY 14, 1975
REVISED JAN., 1983