

REMONUMENTATION

NOV 21 1997

COMMISSION

LIBER 2 PAGE 138

REMONUMENTATION
LAND CORNER RECORDATION CERTIFICATE
Filing Requirement of Act 74, Mich. P.A. 1970

RECEIVED FOR RECORD

97 SEP -9 AM 8:58

LIBER NO. 2 PAGE NO. 138

ESTHER LEE
REGISTER OF DEEDS
SANILAC CO. MICHIGAN

For corners in

Sanilac (County)	Located in:	Corner Code #
1. Public Land Survey	T 11N R 13E	L - 13
	T R	
	T R	
	T R	
2. Property Controlling in Section	S T R	Legs
	S T R	
3. Miscellaneous Property in Sec.	S T R	
	S T R	

Register of Deeds Stamp & File Number

- 4. Lot No. _____, Recorded Plat _____
- 5. Private Claims _____

	A	B	C	D	E	F	G	H	I	J	K	L	M
1													
2	6		5		4		3		2		1		
3													
4	7		8		9		10		11		12		
5													
6	18		17		16		15		14		13		
7													
8	19		20		21		22		23		24		
9													
10	30		29		28		27		26		25		
11													
12	31		32		33		34		35		36		
13													

I, John A. Milletics, in a field survey on June 21, 1997 do hereby state that under requirements of P.A. 74, Michigan P.A. of 1970, the corner points mentioned in lines 1 and 2 above were in conformance with regulations and rules therefore as required in the current manual of survey instructions of the United States Department of the Interior, Bureau of Land Management or by a decree of a Court of Law and/or that the corner points mentioned in lines 3, 4 and 5 above were in conformance with the rules of the Michigan Board of Land Surveyors or by a Decree of a Court of Law; established, re-established, monumented, recovered, found as expressed below:

NOTE: Not more than 2 corners, all in the same town and range, may be recorded on this certificate.

A. Description of original monument and accessories and/or subsequent restoration:

L - 13
GLO NOTES
Beech 8 N29W 8
Beech 11 N37½E 19½


APPROVED PEER BOARD MEETING
Aug 18, 1997 JM

B. Description of corner evidence found and/or method applied in restoring or reestablishing corner:

L - 13
S 1/4 Corner Section 36 T11N-R13E
Found Monu Box in place - removed by the Sanilac County Road Comm. during reconstruction of road - REPLACE using Act 74 as recorded in Liber 1 Page 407

C. Description of monument for corner and accessories established to perpetuate locating the position of the corner:

L - 13
S 1/4 Corner Section 36 T11N-R13E
MONU BOX with iron and cap
N30°W 50.82 feet to the SE Cor of a Old Church
N50°E 108.98 feet to the SW Cor of a Old School
N05°E 118.30 feet to the nail in a 36" Maple
N70°E 102.18 feet to the nail in a 36" Maple
N70°W 69.84 feet to the nail in a 48" Maple

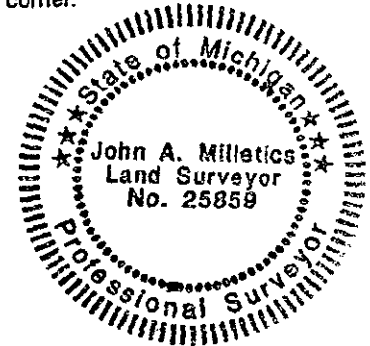

Signed by John A. Milletics
Surveyor's Michigan License No. 25859

Date Aug 11, 1997