

NOV 21 1997

LIBER

2 PAGE 133

COMMISSION

REMONUMENTATION
LAND CORNER RECORDATION CERTIFICATE
Filing Requirement of Act 74, Mich. P.A. 1970

RECEIVED FOR RECORD

97 SEP -9 AM 8:57

LIBER NO. 2 PAGE NO. 133

ESTHER LEE
REGISTER OF DEEDS
SANILAC CO. MICHIGAN

For corners in

Sanilac

(County)

Located in:

Corner Code #

- 1. Public Land Survey T11NR13E G - 13
T R
T R
T R
- 2. Property Controlling S T R
in Section S T R
3. Miscellaneous S T R
Property in Sec. S T R

- 4. Lot No. _____, Recorded Plat _____
- 5. Private Claims _____

Register of Deeds Stamp & File Number

I, John A Milletics, in a field survey on Aug 11, 1997 do hereby state that under requirements of P.A. 74, Michigan P.A. of 1970, the corner points mentioned in lines 1 and 2 above were in conformance with regulations and rules therefore as required in the current manual of survey instructions of the United States Department of the Interior, Bureau of Land Management or by a decree of a Court of Law and/or that the corner points mentioned in lines 3, 4 and 5 above were in conformance with the rules of the Michigan Board of Land Surveyors or by a Decree of a Court of Law; established, re-established, monumented, recovered, found as expressed below:

NOTE: Not more than 2 corners, all in the same town and range, may be recorded on this certificate.

	A	B	C	D	E	F	G	H	I	J	K	L	M
1													
2	6		5		4		3		2		1		
3													
4	7		8		9		10		11		12		
5													
6	10		17		16		15		14		13		
7													
8	19		20		21		22		23		24		
9													
10	30		29		28		27		26		25		
11													
12	31		32		33		34		35		36		
13													

A. Description of original monument and accessories and/or subsequent restoration:

- G - 13
- GLO Notes
- Pine 10 N56°E 14
- Black Ash N78°W 30

APPROVED PEER BOARD MEETING


Aug 18, 1997 JM

B. Description of corner evidence found and/or method applied in restoring or reestablishing corner:

- G - 13
- SW Corner Section 34 T11N-R13E
- Found Monu Box in Place - removed by the Sanilac County Road Comm. during reconstruction of Road - REPLACED using Act 74 as recorded in Liber 1 Page 408

C. Description of monument for corner and accessories established to perpetuate locating the position of the corner:

- G - 13
- SW Corner Section 34 T11N-R13E
- MOUN BOX with iron and cap
- South 76.61 feet to a riser box
- West 48.83 feet to a Monu Box NW Cor Section 2
- East 2646.00 feet to the S 1/4 Corner Section 34
- N60°E 129.86 feet to a nail in a Power Pole
- S45°W 51.50 feet to a Stop Sign
- N05°W 51.50 feet to the East end of a 12" CMP

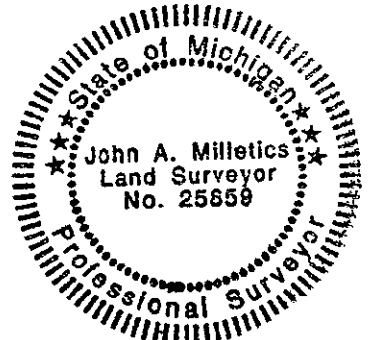

Signed by John A. Milletics
Surveyor's Michigan License No. 25859

Date Aug 11, 1997