REMONUMENTATE

JAN 19 2000

SECTION

LIBER 2 PAGE 326

RECEIVED FOR RECORD

99 NOV 30 AM 9:03

LIBER NO. 2 PAGE NO. 326
MICHELE VANNORMAN
REGISTER OF DEEDS
SANILAC CO., MICHIGAN

1999 REMONUMENTATION PROGRAM
LAND CORNER RECORDATION CERTIFICATE
Filing Requirement of Act 74, Mich. P.A. 1970

For corners in

SANILAC
(County)

	Located In:	Corner Code #
1. Public Land Survey	T 11N R 14E	A-8
	T___ R___	
	T___ R___	
	T___ R___	
2. Property Controlling in Section	S___ T___ R___	
	S___ T___ R___	
3. Miscellaneous Property in Sec.	S___ T___ R___	
	S___ T___ R___	

Register of Deeds Stamp & File Number

4. Lot No. _____, Recorded Plat _____
5. Private Claims _____

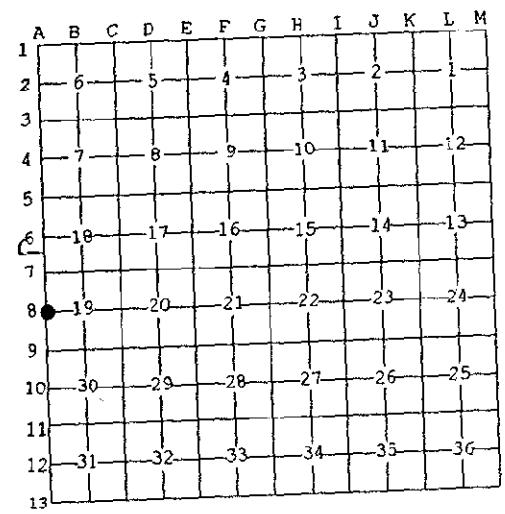

I, John A. Milletics, in a field survey on Aug. 2, 19 99 do hereby state that under requirements of P.A. 74, Michigan P.A. of 1970, the corner points mentioned in lines 1 and 2 above were in conformance with regulations and rules therefore as required in the current manual of survey instructions of the United States Department of the Interior, Bureau of Land Management or by a decree of a Court of Law and /or that the corner points mentioned in lines 3, 4 and 5 above were in conformance with the rules of the Michigan Board of Land Surveyors or by a Decree of a Court of Law; established, re-established, monumented, recovered, found as expressed below:

NOTE: Not more than 2 corners, all in the same town and range, may be recorded on this certificate.

A. Description of original monument and accessories and/or subsequent restoration:

A-8 Hemlock 10 S72W 18; DO 9 N19W 26
Old Survey Liber - None
Unrecorded Survey dated 10-14-87
Act 132 - Liber 3 Page 570

B. Description of corner evidence found and/or method applied in restoring or reestablishing corner:

A-8
W 1/4 Corner Section 19, T11N-R14E
Found 1/2" Iron Bar in gravel Road Bed
North 2656.65 feet to the NW Corner
South 2654.42 feet to the SW Corner
Accepted as best evidence

APPROVED PEER BOARD MEETING
NOV 19, 1999
JM

C. Description of monument for corner and accessories established to perpetuate locating the position of the corner:

A - 8
W 1/4 Corner Section 19 T11N-R14E
1/" Iron Bar in gravel Road Bed
North 2656.65 feet to the NW Corner
South 2654.42 feet to the SW Corner
N30°E 245.10 feet to a nail in a Power Pole
S30°E 181.65 feet to a nail in a Power Pole
West 33.00 feet to a 1/2" Iron

Signed by _____ Date Nov 2, 1999
Surveyor's Michigan License No. 25859

FORM APPROVED BY MICHIGAN STATE BOARD OF PROFESSIONAL SURVEYORS, JAN. 28, 1971
REVISED MAY 14, 1975
REVISED JAN., 1983
REVISED OCT., 1995