

SURVEY & REMONUMENTATION

APR 14 1998

SECTION REMONUMENTATION

LIBER 2 PAGE 161

LAND CORNER RECORDATION CERTIFICATE Filing Requirement of Act 74, Mich. P.A. 1970

RECEIVED FOR RECORD 97 DEC -2 AM 9:09

LIBER NO. 2 PAGE NO. 161 ESTHER LEE REGISTER OF DEEDS SANILAC CO., MICHIGAN

For corners in WATERTOWN TOWNSHIP

Table with columns: Sanilac (County), Located In, Corner Code #. Rows include Public Land Survey, Property Controlling in Section, and Miscellaneous Property in Sec.

REMONUMENTATION

JAN 08 1998

COMMISSION

Register of Deeds Stamp & File Number

4. Lot No. , Recorded Plat 5. Private Claims

I, John A Milletics, in a field survey on July 14, 1997 do hereby state that under requirements of P.A. 74, Michigan P.A. of 1970, the corner points mentioned in lines 1 and 2 above were in conformance with regulations and rules therefore as required in the current manual of survey instructions of the United States Department of the Interior, Bureau of Land Management or by a decree of a Court of Law and /or that the corner points mentioned in lines 3, 4 and 5 above were in conformance with the rules of the Michigan Board of Land Surveyors or by a Decree of a Court of Law; established, re-established, monumented, recovered, found as expressed below:

NOTE: Not more than 2 corners, all in the same town and range, may be recorded on this certificate.

Grid table with columns A-M and rows 1-13. Contains numbers 6 through 36.

A. Description of original monument and accessories and/or subsequent restoration:

A - 9

GLO Notes

Set Post Corner Maple 16, S34°W 39 1/2 B.Oak 22, N32°W 50 1/2

Old Survey Liber, survey dated April, 1921 by Lotan Reed Act 74 None Act 132 None

B. Description of corner evidence found and/or method applied in restoring or reestablishing corner:

A - 9


Found 1/2" Iron Bar 1' Deep under pavement

APPROVED PEER BOARD MEETING NOV. 26, 1997

C. Description of monument for corner and accessories established to perpetuate locating the position of the corner:

A - 9

SW Corner Section 19 T11N-R14E Watertown Twp. Monu Box in place with 1/2" iron bar with cap N60°W 88.50 feet to a nail in a Power Pole S45°W 84.35 feet to a nail in a Power Pole N30°W 38.90 feet to a stop sign S75°E 64.71 feet to a road sign East 2574.25 feet to the S 1/4 Cor Section 19

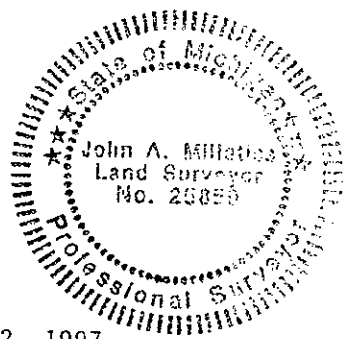

Signed by [Signature] Surveyor's Michigan License No. 25859

Date Nov 12, 1997