

JAN 19 2000

LIBER

2 PAGE 327

RECEIVED FOR RECORD

99 NOV 30 AM 9:03

SECTION

1999 REMONUMENTATION PROGRAM  
LAND CORNER RECORDATION CERTIFICATE  
Filing Requirement of Act 74, Mich. P.A. 1970

LIBER NO. 2 PAGE NO. 327  
MICHELE VANNORMAN  
REGISTER OF DEEDS  
SANILAC CO., MICHIGAN

For corners in

SANILAC

(County)

Located In:

Corner Code #

- 1. Public Land Survey      T 11NR 14 E      A-10  
                                   T    R                                     
                                   T    R                                     
                                   T    R
- 2. Property Controlling    S    T    R                                     
    in Section                S    T    R
- 3. Miscellaneous            S    T    R                                     
    Property in Sec.         S    T    R

Register of Deeds Stamp & File Number

- 4. Lot No. \_\_\_\_\_, Recorded Plat \_\_\_\_\_
- 5. Private Claims \_\_\_\_\_

I, John A. Millettics, in a field survey on Aug. 2, 19 99 do hereby state that under requirements of P.A. 74, Michigan P.A. of 1970, the corner points mentioned in lines 1 and 2 above were in conformance with regulations and rules therefore as required in the current manual of survey instructions of the United States Department of the Interior, Bureau of Land Management or by a decree of a Court of Law and /or that the corner points mentioned in lines 3, 4 and 5 above were in conformance with the rules of the Michigan Board of Land Surveyors or by a Decree of a Court of Law; established, re-established, monumented, recovered, found as expressed below:

NOTE: Not more than 2 corners, all in the same town and range, may be recorded on this certificate.

	A	B	C	D	E	F	G	H	I	J	K	L	M
1													
2	6		5		4		3		2		1		
3													
4	7		8		9		10		11		12		
5													
6	18		17		16		15		14		13		
7													
8	19		20		21		22		23		24		
9													
10	30		29		28		27		26		25		
11													
12	31		32		33		34		35		36		
13													

A. Description of original monument and accessories and/or subsequent restoration:

A-10 W. Oak 13 N41W 28 1/2; Birch 14 S14W 5 1/2  
Old Survey Liber - None  
Act 132 - None  
L.C.R.C. - None  
Unrecorded survey (Kay Eng) dated April 1977

B. Description of corner evidence found and/or method applied in restoring or reestablishing corner:


A-10  
W 1/4 Corner Section 30, T11N-R14E  
Found 1/2" Iron 2' deep in gravel road bed raised with 1/2" Iron  
North 2648.55 to NW Corner Section  
South 2648.55 to SW Corner Section

APPROVED PEER BOARD MEETING  
NOV 19, 1999

*gm*

C. Description of monument for corner and accessories established to perpetuate locating the position of the corner:

A - 10  
W 1/4 Corner Section 30 T11N-R14E  
1/2" Iron Bar in Gravel Road Bed  
North 2648.55 feet to the NW Corner  
South 2648.55 feet to the SW Corner  
West 61.00 feet to a nail in a Power Pole  
N80°E 26.55 feet to the South end of a 12" CMP  
N45°E 38.40 feet to the North end of a 12" CMP

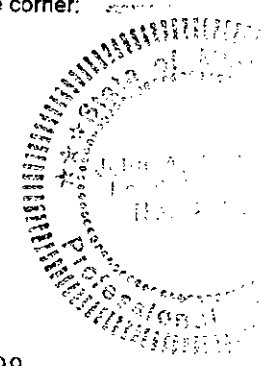

Signed by *John A. Millettics*  
Surveyor's Michigan License No. 25859

Date Nov 3, 1999