

JAN 19 2000

LIBER 2 PAGE 328

SECTION

1999 REMONUMENTATION PROGRAM
LAND CORNER RECORDATION CERTIFICATE
Filing Requirement of Act 74, Mich. P.A. 1970

RECEIVED FOR RECORD

99 NOV 30 AM 9:03

For corners in

SANILAC (County)	Located in:	Corner Code #
1. Public Land Survey	T 11NR 14E	A-11
	T R	
	T R	
	T R	
2. Property Controlling in Section	S T R	
	S T R	
3. Miscellaneous Property in Sec.	S T R	
	S T R	

LIBER NO. 2 PAGE NO. 328
MICHELE VANNORMAN
REGISTER OF DEEDS
SANILAC CO., MICHIGAN

Register of Deeds Stamp & File Number

4. Lot No. _____, Recorded Plat _____
5. Private Claims _____

I, John A. Milletics, in a field survey on Aug. 2, 19 99 do hereby state that under requirements of P.A. 74, Michigan P.A. of 1970, the corner points mentioned in lines 1 and 2 above were in conformance with regulations and rules therefore as required in the current manual of survey instructions of the United States Department of the Interior, Bureau of Land Management or by a decree of a Court of Law and /or that the corner points mentioned in lines 3, 4 and 5 above were in conformance with the rules of the Michigan Board of Land Surveyors or by a Decree of a Court of Law; established, re-established, monumented, recovered, found as expressed below:

	A	B	C	D	E	F	G	H	I	J	K	L	M
1													
2	6		5		4		3		2		1		
3													
4	7		8		9		10		11		12		
5													
6	18		17		16		15		14		13		
7													
8	19		20		21		22		23		24		
9													
10	30		29		28		27		26		25		
11													
12	31		32		33		34		35		36		
13													

NOTE: Not more than 2 corners, all in the same town and range, may be recorded on this certificate.

A. Description of original monument and accessories and/or subsequent restoration:

A-11 Hemlock 22 N18 1/2W 25 1/2; D0 11 S65 1/2W 20 1/2
Old Survey Liber - None
L.C.R.C. - None
Unrecorded survey Dated Aug 1987
Act 132 - None


B. Description of corner evidence found and/or method applied in restoring or reestablishing corner:

A-11
SW Corner Section 30, T11N-R14E
Found 1/2" Iron Bar 2' deep in gravel road bed
North 2648.55 feet to the W 1/4 Corner Section 30
South 2653.78 feet to the W 1/4 Corner Section 31
Accepted as best evidence

APPROVED PEER BOARD MEETING
NOV 19, 1999

C. Description of monument for corner and accessories established to perpetuate locating the position of the corner:

A - 11
SW Corner Section 30 T11N-R14E
1/2" Iron Bar with cap in gravel road bed
North 2648.55 feet to the W 1/4 Corner Section 30
South 2653.78 feet to the W 1/4 Corner Section 31
N45°W 105.75 feet to a nail in a Power Pole
N45°E 54.70 feet to the SW Corner of a Bell Riser Box
N55°E 38.35 feet to a stop sign
S45°W 33.90 feet to a stop sign

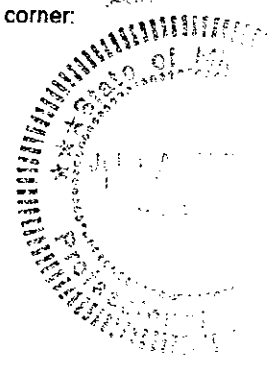

Signed by John A. Milletics
Surveyor's Michigan License No. 25859

Date Nov 3, 1999