

NOV 21 1997

LIBER

2 PAGE 140

COMMISSION

REMONUMENTATION
LAND CORNER RECORDATION CERTIFICATE
Filing Requirement of Act 74, Mich. P.A. 1970

RECEIVED FOR RECORD

97 SEP -9 AM 8:58

LIBER NO. 2 PAGE NO. 140
ESTHER LEE
REGISTER OF DEEDS
SANILAC CO. MICHIGAN

For corners in

Sanilac (County)	Located In:	Corner Code #
1. Public Land Survey	T11N R14E	B - 13
	T R	
	T R	
	T R	
	T R	
2. Property Controlling in Section	S T R	Seg 2
	S T R	
3. Miscellaneous Property in Sec.	S T R	
	S T R	

Register of Deeds Stamp & File Number

4. Lot No. _____, Recorded Plat _____
5. Private Claims _____

I, John A. Milletics, in a field survey on June 21, 1997 do hereby state that under requirements of P.A. 74, Michigan P.A. of 1970, the corner points mentioned in lines 1 and 2 above were in conformance with regulations and rules therefore as required in the current manual of survey instructions of the United States Department of the Interior, Bureau of Land Management or by a decree of a Court of Law and/or that the corner points mentioned in lines 3, 4 and 5 above were in conformance with the rules of the Michigan Board of Land Surveyors or by a Decree of a Court of Law; established, re-established, monumented, recovered, found as expressed below:

NOTE: Not more than 2 corners, all in the same town and range, may be recorded on this certificate.

	A	B	C	D	E	F	G	H	I	J	K	L	M					
1																		
2	6			5			4			3			2	1				
3																		
4	7						8			9			10	11	12			
5																		
6	10									15			14		13			
7																		
8	19									20			21		22	23	24	
9																		
10	30									29			28		27		26	25
11																		
12	31									32			33		34		35	36
13																		

A. Description of original monument and accessories and/or subsequent restoration:

B - 13

GLO NOTES

Beech 7 N55 1/2°W 8
Beech 6 N54°E 4

APPROVED PEER BOARD MEETING

Aug 18, 1997 - gm

B. Description of corner evidence found and/or method applied in restoring or reestablishing corner:

B - 13

S 1/4 Corner Section 31 T11N-R14E

Found Moun Box in place - removed by Sanilac County Road Comm during reconstruction of Road - REPLACED using Act 74 as recorded in Liber 1 Page 409

C. Description of monument for corner and accessories established to perpetuate locating the position of the corner:

B - 13

S 1/4 Corner Section 31 T11N-R14E


MONU BOX with iron and cap

N05°W 36.40 to a nail in a Fence Post

N50°W 63.90 to a nail in a Fence Post

N50°E 45.75 to a nail in a Fence Post

East 2645.08 feet to the SE Corner Section 31 (MONU BOX)

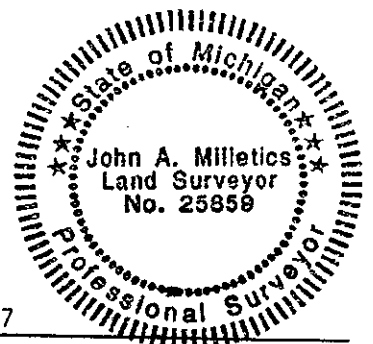

Signed by John A. Milletics
Surveyor's Michigan License No. 25859

Date Aug 11, 1997