

SURVEY & REMONUMENTATION

APR 14 1998

SECTION REMONUMENTATION

LIBER

2 PAGE 163

LAND CORNER RECORDATION CERTIFICATE Filing Requirement of Act 74, Mich. P.A. 1970

For corners in WATERTOWN TOWNSHIP

Sanilac (County)	Located In:	Corner Code #
1. Public Land Survey	T11NR 14E	C - 9
	T R	
	T R	
	T R	
2. Property Controlling in Section	S T R	
	S T R	
3. Miscellaneous Property in Sec.	S T R	
	S T R	

RECEIVED FOR RECORD

97 DEC -2 AM 9:09

LIBER NO. 2 PAGE NO. 163
ESTHER LEE
REGISTER OF DEEDS
SANILAC CO. MICHIGAN

SURVEY & REMONUMENTATION

JAN 08 1998

Register of Deeds File Number SECTION

4. Lot No. _____, Recorded Plat _____
5. Private Claims _____

I, John A Millettics, in a field survey on July 29, 1997 do hereby state that under requirements of P.A. 74, Michigan P.A. of 1970, the corner points mentioned in lines 1 and 2 above were in conformance with regulations and rules therefore as required in the current manual of survey instructions of the United States Department of the Interior, Bureau of Land Management or by a decree of a Court of Law and/or that the corner points mentioned in lines 3, 4 and 5 above were in conformance with the rules of the Michigan Board of Land Surveyors or by a Decree of a Court of Law; established, re-established, monumented, recovered, found as expressed below:

NOTE: Not more than 2 corners, all in the same town and range, may be recorded on this certificate.

	A	B	C	D	E	F	G	H	I	J	K	L	M
1													
2	6		5		4		3		2		1		
3													
4	7		8		9		10		11		12		
5													
6	18		17		16		15		14		13		
7													
8	19		20		21		22		23		24		
9													
10	30		29		28		27		26		25		
11													
12	31		32		33		34		35		36		
13													

A. Description of original monument and accessories and/or subsequent restoration:

C - 9

GLO Notes

Set Post Corner
Beech 12 S82°E 17
Birch 12 N59°W 26

Old Survey Liber, survey dated April 1921 by Lotan Reed
Act 74 None
Act 132 None
Unrecorded survey dated 7-15-88

B. Description of corner evidence found and/or method applied in restoring or reestablishing corner:

C - 9


Found 5/8" Iron Bar 6" deep under paved surface.

APPROVED PEER BOARD MEETING
NOV. 26, 1997

C. Description of monument for corner and accessories established to perpetuate locating the position of the corner:

C - 9

SW Cor Section 20 T11N-R14E Watertown Twp.
Monu Box with 1/2" iron bar with cap
N40°E 76.09 feet to a nail in a Power Pole
S30°E 58.45 feet to a nail in a Tele Pole
N30°W 39.00 feet to a stop sign
West 2652.49 feet to the S 1/4 Corner Section 19
East 2660.28 feet to the S 1/4 Corner Section 20

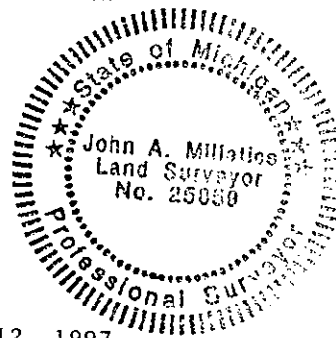

Signed by John A. Millettics
Surveyor's Michigan License No. 25859

Date Nov 12, 1997