

SURVEY & REMONUMENTATION

APR 14 1998

LIBER 2 PAGE 164

RECEIVED FOR RECORD

97 DEC -2 AM 9:09

REMONUMENTATION SECTION

LAND CORNER RECORDATION CERTIFICATE
Filing Requirement of Act 74, Mich. P.A. 1970

LIBER NO. 21 PAGE NO. 164

For corners in WATERTOWN TOWNSHIP

ESTHER LEE
REGISTER OF DEEDS
SANILAC CO., MICHIGAN

SURVEY & REMONUMENTATION

JAN 08 1998

SECTION

Register of Deeds Stamp & File Number

Sanilac (County)	Located In:	Corner Code #
1. Public Land Survey	T11N R14E	D - 9
	T R	
	T R	
	T R	
2. Property Controlling in Section	S T R	
	S T R	
3. Miscellaneous Property in Sec.	S T R	
	S T R	

4. Lot No. _____, Recorded Plat _____
5. Private Claims _____

I, John A Milletics, in a field survey on July 29, 1997 do hereby state that under requirements of P.A. 74, Michigan P.A. of 1970, the corner points mentioned in lines 1 and 2 above were in conformance with regulations and rules therefore as required in the current manual of survey instructions of the United States Department of the Interior, Bureau of Land Management or by a decree of a Court of Law and/or that the corner points mentioned in lines 3, 4 and 5 above were in conformance with the rules of the Michigan Board of Land Surveyors or by a Decree of a Court of Law; established, re-established, monumented, recovered, found as expressed below:

NOTE: Not more than 2 corners, all in the same town and range, may be recorded on this certificate.

	A	B	C	D	E	F	G	H	I	J	K	L	M
1													
2	6		5		4		3		2		1		
3													
4	7		8		9		10		11		12		
5													
6	18		17		16		15		14		13		
7													
8	19		20		21		22		23		24		
9													
10	30		29		28		27		26		25		
11													
12	31		32		33		34		35		36		
13													

A. Description of original monument and accessories and/or subsequent restoration:

D - 9

GLO Notes

Set 1/4 Section Post
Hemlock 16, N06°W 33
Birch 10 S22½°E 17

Old Survey Liber, survey dated Sept. 1907
by Thomas Nicol
Act 74 None
Act 132 None
Unrecorded survey dated 7-15-88

B. Description of corner evidence found and/or method applied in restoring or reestablishing corner:

D - 9


Found 1" Bar 6" under blacktop surface

APPROVED PEER BOARD MEETING
NOV. 26, 1997 *JM*

C. Description of monument for corner and accessories established to perpetuate locating the position of the corner:

D - 9

S 1/4 Cor Section 20 T11N-R14E
Moun Box in place with 1" iron bar
N70°E 68.84 feet to a nail in a Power Pole
S45°W 58.15 feet to a nail in a Power Pole
S30°E 40.60 feet to a stop sign
N30°W 43.54 feet to a stop sign
East 2665.70 feet to the SE Corner Section 20
West 2660.28 feet to the SW Corner Section 20

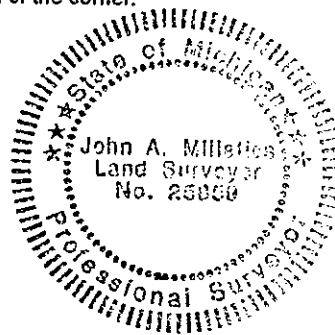

Signed by *John A. Milletics*
Surveyor's Michigan License No. 25859

Date Nov 11, 1997