

SURVEY & REMONUMENTATION

APR 14 1998

LIBER 2 PAGE 165

RECEIVED FOR RECORD

97 DEC -2 AM 9:09

REMONUMENTATION SECTION

LAND CORNER RECORDATION CERTIFICATE
Filing Requirement of Act 74, Mich. P.A. 1970

LIBER NO. 2 PAGE NO. 165
ESTHER LEE
REGISTER OF DEEDS
SANILAC CO., MICHIGAN

For corners in WATERTOWN TOWNSHIP

Sanilac (County)	Located In:	Corner Code #
	T11N R14E	E - 9
1. Public Land Survey	T R	
	T R	
	T R	
2. Property Controlling in Section	S T R	
	S T R	
3. Miscellaneous Property in Sec.	S T R	
	S T R	

SURVEY & REMONUMENTATION

JAN 08 1998

Register of Deeds Stamp & File Number

4. Lot No. _____, Recorded Plat _____
5. Private Claims _____

I, John A. Milletics, in a field survey on July 29, 1997 do hereby state that under requirements of P.A. 74, Michigan P.A. of 1970, the corner points mentioned in lines 1 and 2 above were in conformance with regulations and rules therefore as required in the current manual of survey instructions of the United States Department of the Interior, Bureau of Land Management or by a decree of a Court of Law and for that the corner points mentioned in lines 3, 4 and 5 above were in conformance with the rules of the Michigan Board of Land Surveyors or by a Decree of a Court of Law; established, re-established, monumented, recovered, found as expressed below:

NOTE: Not more than 2 corners, all in the same town and range, may be recorded on this certificate.

	A	B	C	D	E	F	G	H	I	J	K	L	M
1													
2	6		5		4		3		2		1		
3													
4	7		8		9		10		11		12		
5													
6	10		17		16		15		14		13		
7													
8	19		20		21		22		23		24		
9													
10	30		29		28		27		26		25		
11													
12	31		32		33		34		35		36		
13													

A. Description of original monument and accessories and/or subsequent restoration:

E - 9

GLO Notes

Set Post Corner
Birch 13 N78°E 39
Hemlock 10 S81°W 20

Old Survey Liber, survey dated April 1907
by Thomas Nicol
Act 132 None
Act 74 None
Unrecorded survey dated 12-17-90 & 05-04-90
with sectional breck down.
State Highway Right of Way Book

B. Description of corner evidence found and/or method applied in restoring or reestablishing corner:

E - 9


Found Monu Box in pavement

APPROVED PEER BOARD MEETING
NOV. 26, 1997 *JM*

C. Description of monument for corner and accessories established to perpetuate locating the position of the corner:

E - 9

SE Corner Section 20 T11N-R14E Watertown Twp.
Monu Box with bolt spike in place
East 1.50 feet to the existing centerline
S45°W 59.22 feet to a nail in a Power Pole
N45°W 67.74 feet to a nail in a Power Pole
S45°E 71.37 feet to a concrete project marker
N45°E 68.25 feet to a nail in a Tele Pole
West 2665.70 feet to the S 1/4 Corner Section 20

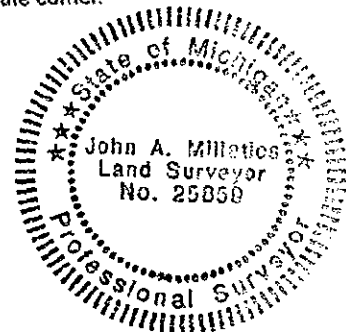

Signed by *John A. Milletics*
Surveyor's Michigan License No. 25859

Date Nov 11, 1997