

NOV 21 1997

COMMISSION

LIBER

2 PAGE 141

REMONUMENTATION

LAND CORNER RECORDATION CERTIFICATE  
Filing Requirement of Act 74, Mich. P.A. 1970

RECEIVED FOR RECORD

97 SEP -9 AM 8:58

LIBER NO. 2 PAGE NO. 141  
ESTHER LEE  
REGISTER OF DEEDS  
SANILAC CO., MICHIGAN

For corners in

Sanilac  
(County)

Located In:

Corner Code #

- 1. Public Land Survey T 11N R 14E C - 13  
T R  
T R  
T R
- 2. Property Controlling in Section S T R  
S T R
- 3. Miscellaneous Property in Sec. S T R  
S T R

- 4. Lot No. \_\_\_\_\_, Recorded Plat \_\_\_\_\_
- 5. Private Claims \_\_\_\_\_

Register of Deeds Stamp & File Number

I, John A. Milletics, in a field survey on June 21, 1997 do hereby state that under requirements of P.A. 74, Michigan P.A. of 1970, the corner points mentioned in lines 1 and 2 above were in conformance with regulations and rules therefore as required in the current manual of survey instructions of the United States Department of the Interior, Bureau of Land Management or by a decree of a Court of Law and /or that the corner points mentioned in lines 3, 4 and 5 above were in conformance with the rules of the Michigan Board of Land Surveyors or by a Decree of a Court of Law; established, re-established, monumented, recovered, found as expressed below:

NOTE: Not more than 2 corners, all in the same town and range, may be recorded on this certificate.

	A	B	C	D	E	F	G	H	I	J	K	L	M
1													
2	6		5		4		3		2		1		
3													
4	7		8		9		10		11		12		
5													
6	18		17		16		15		14		13		
7													
8	19		20		21		22		23		24		
9													
10	30		29		28		27		26		25		
11													
12	31		32		33		34		35		36		
13													

A. Description of original monument and accessories and/or subsequent restoration:

- C - 13
- GLO NOTES
- Birch 14 N57W 28
- Hemlock 14 N33E 8½

APPROVED PEER BOARD MEETING


Aug 18, 1997 JM

B. Description of corner evidence found and/or method applied in restoring or reestablishing corner:

- C - 13
- Found Monu Box in place - removed by the Sanilac County Road Comm. during reconstruction of Road - REPLACED using Act 74 as recorded in Liber 1 Page 406

C. Description of monument for corner and accessories established to perpetuate locating the position of the corner:

- C - 13
- SE Corner Section 31 T11N-R14E
- MONU BOX with iron and cap
- South 18.10 feet to the West leg of a Road Sign
- S05°E 18.15 feet to the East leg of a Road Sign
- N45°E 62.00 feet to a nail in a Tele Pole
- N30°E 38.40 feet to the East end of a 24" CMP
- S45°E 57.70 feet to a nail in a Fence Post
- N40°W 62.08 feet to a nail in a Post

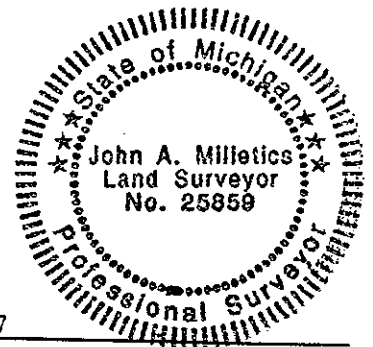

Signed by [Signature]  
Surveyor's Michigan License No. 25859

Date Aug 11, 1997