JAN 19 2000

LIBER 2 PAGE 358

RECEIVED FOR RECORD
99 NOV 30 AM 9:04
LIBER NO 2 PAGE NO 358
MICHELE VANNORMAN
REGISTER OF DEEDS
SANILAC CO., MICHIGAN

SECTION

1999 REMONUMENTATION PROGRAM
LAND CORNER RECORDATION CERTIFICATE
Filing Requirement of Act 74, Mich. P.A. 1970

For corners in

SANILAC (County) Located In: Corner Code #

1. Public Land Survey		T 11N	R 16 E	A-2
		T___	R___	
		T___	R___	
		T___	R___	
2. Property Controlling in Section	S___	T___	R___	
	S___	T___	R___	
3. Miscellaneous Property in Sec.	S___	T___	R___	
	S___	T___	R___	

Register of Deeds Stamp & File Number

4. Lot No. _____, Recorded Plat _____
5. Private Claims _____

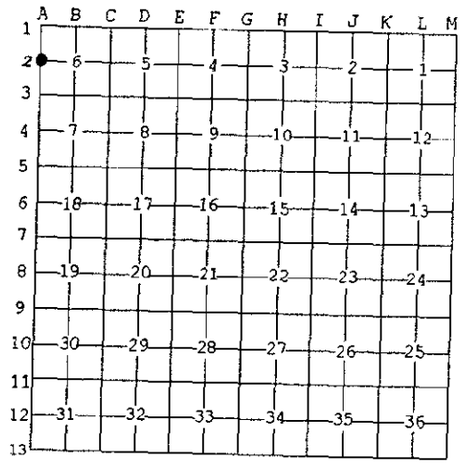

I, John A. Milletics, in a field survey on Aug. 2, 19 99 do hereby state that under requirements of P.A. 74, Michigan P.A. of 1970, the corner points mentioned in lines 1 and 2 above were in *conformance with regulations* and rules therefore as required in the current manual of survey instructions of the United States Department of the Interior, Bureau of Land Management or by a decree of a Court of Law and /or *that the corner points* mentioned in lines 3, 4 and 5 above were in conformance with the rules of the Michigan Board of Land Surveyors or by a Decree of a Court of Law; established, re-established, monumented, *recovered, found as expressed below:*

NOTE: Not more than 2 corners, all in the same town and range, may be recorded on this certificate.

A. Description of original monument and accessories and/or subsequent restoration:

A-2 Hemlock 12 S58W 14; DO 22 N13W 33 1/2
Old Survey Liber _ None
Act 132 - None
L.C.R.C. - None
Unrecorded survey - Milletics Dated May 1994, Milletics Dated Aug 1999
Kay Eng Dated Aug 1994

B. Description of corner evidence found and/or method applied in restoring or reestablishing corner:

A-2
W 1/4 Corner Section 6, T11N-R16E
Found 1/2" Iron bar in gravel Road Bed
North 2650.40 feet to the NW Corner Section 6
South 2650.40 feet to the SW Corner Section 6
Accpeted as best evidence

APPROVED PEER BOARD MEETING
NOV 19, 1999

C. Description of monument for corner and accessories established to perpetuate locating the position of the corner:

A- 2
W 1/4 Corner Section 6, T11N-R16E
1/2 Iron Bar in gravel Road Bed
North 2650.40 feet to the NW Corner
South 2650.40 feet to the SW Corner
West 42.15 feet to a nail in a Power Pole
East 33.00 feet to a 1/2" Iron Bar
N80°E 32.30 feet a nail in a ThornApple Tree
S70°E 35.08 feet to a nail in a Power Pole

Signed by _____ Date 11-15-1999
Surveyor's Michigan License No. 25859

FORM APPROVED BY MICHIGAN STATE BOARD OF PROFESSIONAL SURVEYORS, JAN. 28, 1971
REVISED MAY 14, 1975
REVISED JAN., 1983
REVISED OCT., 1995