SURVEY &
REMONUMENTATION

LIBER 1 PAGE 435

1993
REMONUMENTATION COMMISSION

LAND CORNER RECORDATION CERTIFICATE

Filing Requirement of Act 74, Mich. P.A. 1970

For corners in Sanilac (County) Located In: Corner Code #

RECEIVED FOR RECORD
93 DEC 29 AM 10: 56
LIBER 1 PAGE NO. 435
ESTHER LEE
REGISTER OF DEEDS
SANILAC CO., MICHIGAN

Register of Deeds Stamp & File Number

1. Public Land Survey		T 11N R 16E	B - 13, A - 13
		T ___ R ___	
		T ___ R ___	
		T ___ R ___	
2. Property Controlling	S ___	T ___ R ___	
in Section	S ___	T ___ R ___	
3. Miscellaneous	S ___	T ___ R ___	
Property in Sec.	S ___	T ___ R ___	

4. Lot No. _____ , Recorded Plat _____
5. Private Claims _____

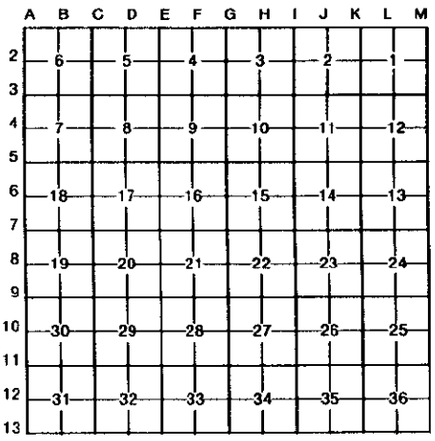

I, John A Milletics, in a field survey on Oct 13, 19 93, do hereby certify that under requirements of P.A. 74, Michigan P.A. of 1970, the corner points mentioned in lines 1 and 2 above were in conformance with regulations and rules therefore as required in the current manual of survey instructions of the United States Department of the Interior, Bureau of Land Management or by a decree of a Court of Law and/or that the corner points mentioned in lines 3, 4 and 5 above were in conformance with the rules of the Michigan Board of Land Surveyors or by a Decree of a Court of Law; established, re-established, monumented, re-monumented, recovered, found as expressed below:

NOTE: Not more than 4 corners, all in the same town and range, may be recorded on this certificate.

A. Description of original monument and accessories and/or subsequent restoration:

B - 13

Found 1" iron bar in gravel road bed, per survey recorded in Liber 4, Page 633 of the Sanilac County Records.

A - 13

Found 5/8" iron bar in gravel Road Bed, per survey recorded in Liber 3 Page 745 of the Sanilac County Records.

B. Description of corner evidence found and/or method applied in restoring or reestablishing corner:

B - 13
S 1/4 Cor Section 31 T11N-R16E
Found 1" iron bar

A - 13
SW Cor Section 31 T11N-R16E
Found 5/8" iron bar

C. Description of monument for corner and accessories established to perpetuate locating the position of the corner:

B - 13
S 1/4 Cor Section 31 T11N-R16E
1" iron bar
S50°E 43.00' to a nail in a 24" Maple
S20°E 31.20' to a nail in a 24" Maple
S10°W 29.86' to a nail in a 24" Maple

A - 13
SW Cor Section 31 T11N-R16E
5/8" iron bar
N45°E 63.95' to a nail in a Power Pole
N45°W 55.30' to a nail in a Anchor Pole
S20°E 33.40' to a nail in a 24" Ash
S30°W 35.85' to a nail in a 8" Ash

Signed by John A Milletics Date Dec 24, 1993

Surveyor's Michigan License No. 25859

FORM APPROVED BY MICHIGAN STATE BOARD OF LAND SURVEYORS, JAN. 28, 197
REVISED MAY 14, 197
REVISED JAN., 198