

**SURVEY & REMONUMENTATION**

SEP 17 1999

LIBER

2 PAGE 304

RECEIVED FOR RECORD

**SECTION**

1999 REMONUMENTATION PROGRAM  
**LAND CORNER RECORDATION CERTIFICATE**  
 Filing Requirement of Act 74, Mich. P.A. 1970

99 AUG -2 AM 9:09

BOOK NO. 2 PAGE NO. 304

MICHELE VANNORMAN  
 REGISTER OF DEEDS  
 SANILAC CO., MICHIGAN

For corners in

<u>SANILAC</u> (County)	Located In:	Corner Code #
1. Public Land Survey	T12N R12E	A-2
	T ___ R ___	_____
	T ___ R ___	_____
	T ___ R ___	_____
2. Property Controlling in Section	S ___ T ___ R ___	_____
	S ___ T ___ R ___	_____
3. Miscellaneous Property in Sec.	S ___ T ___ R ___	_____
	S ___ T ___ R ___	_____

Register of Deeds Stamp & File Number

4. Lot No. \_\_\_\_\_, Recorded Plat \_\_\_\_\_  
 5. Private Claims \_\_\_\_\_

I, John A. Milletics, in a field survey on April 1, 1999 do hereby state that under requirements of P.A. 74, Michigan P.A. of 1970, the corner points mentioned in lines 1 and 2 above were in conformance with regulations and rules therefore as required in the current manual of survey instructions of the United States Department of the Interior, Bureau of Land Management or by a decree of a Court of Law and /or that the corner points mentioned in lines 3, 4 and 5 above were in conformance with the rules of the Michigan Board of Land Surveyors or by a Decree of a Court of Law; established, re-established, monumented, recovered, found as expressed below.

NOTE: Not more than 2 corners, all in the same town and range, may be recorded on this certificate.

1	A	B	C	D	E	F	G	H	I	J	K	L	M
2	6		5		4		3		2		1		
3													
4	7		8		9		10		11		12		
5													
6	18		17		16		15		14		13		
7													
8	19		20		21		22		23		24		
9													
10	30		29		28		27		26		25		
11													
12	31		32		33		34		35		36		
13													

A. Description of original monument and accessories and/or subsequent restoration:

1834 (Gov't. Land Office Notes) Harvey Parke, D.S.-Set qu. Sec. Post-Beech 12 N4W 28 1/2;  
 Beech 17 S34W 10  
 1981 (Survey-Liber 4 of Surveys Pages 483&484, Sanilac County) Russell L. Brown, P.S. 24588-  
 Set Railroad Spike-N20°E 48.66' to spike in 10" Maple; S80°E 52.52' to spike in 18"  
 Maple; S45°E 40.97' to spike in 24" Maple; N70°E 25.40' to spike in 14" Twin Oak  
 Survey Recorded Liver 4 Page 483 Sanilac Co. (Sanilac Land Surveying)

B. Description of corner evidence found and/or method applied in restoring or reestablishing corner:


A - 2  
 W 1/4 Corner Section 6 T12N-R12E  
 Found Standard Concrete Monument with Brass Cap  
 North 2759.40 feet to the NW Corner Section 6  
 South 2630.35 feet to the SW Corner Section 6  
 Accepted as best evidence

APPROVED PEER BOARD MEETING  
 July 20, 1999

*JM*

C. Description of monument for corner and accessories established to perpetuate locating the position of the corner:

Found Standard Concrete Monument with 2" Brass Cap  
 N24°E, 48.40' T.C. Re-mon. tag above found nail in Southeast face of 12" Ash  
 N60°E, 25.10' T.C. Re-mon. tag above found nail in Southeast face of 18" Twin Cherry  
 S70°E, 52.39' T.C. Re-mon. tag above found nail in South face of 20" Maple  
 S34°E, 40.95' T.C. Re-mon. tag above found nail in West face of 28" Maple  
 West, 17.68' Set 1/2" diameter reinforcing rod

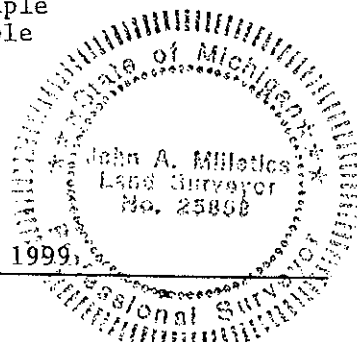

Signed by John A. Milletics  
 Surveyor's Michigan License No. 25859

Date June 30, 1999