

**SURVEY & REMONUMENTATION**

SEP 17 1999

LIBER

2 PAGE 307

RECEIVED FOR RECORD

99 AUG -2 AM 9:09

1999 REMONUMENTATION PROGRAM  
LAND CORNER RECORDATION CERTIFICATE  
Filing Requirement of Act 74, Mich. P.A. 1970

LIBER NO. 2 PAGE NO. 307

For corners in SECTION

MICHELE VANNORMAN  
REGISTER OF DEEDS  
SANILAC CO., MICHIGAN

SANILAC (County)	Located In:	Corner Code #
1. Public Land Survey	T12N R 12E	A-5
	T R	
	T R	
	T R	
2. Property Controlling in Section	S T R	
	S T R	
3. Miscellaneous Property in Sec.	S T R	
	S T R	

Register of Deeds Stamp & File Number

4. Lot No. \_\_\_\_\_, Recorded Plat \_\_\_\_\_  
5. Private Claims \_\_\_\_\_

I, John A. Milletics, in a field survey on April 1, 1999 do hereby state that under requirements of P.A. 74, Michigan P.A. of 1970, the corner points mentioned in lines 1 and 2 above were in conformance with regulations and rules therefore as required in the current manual of survey instructions of the United States Department of the Interior, Bureau of Land Management or by a decree of a Court of Law and/or that the corner points mentioned in lines 3, 4 and 5 above were in conformance with the rules of the Michigan Board of Land Surveyors or by a Decree of a Court of Law; established, re-established, monumented, recovered, found as expressed below:

NOTE: Not more than 2 corners, all in the same town and range, may be recorded on this certificate.

	A	B	C	D	E	F	G	H	I	J	K	L	M
1													
2		6		5		4		3		2		1	
3													
4		7		8		9		10		11		12	
5													
6		18		17		16		15		14		13	
7													
8		19		20		21		22		23		24	
9													
10		30		29		28		27		26		25	
11													
12		31		32		33		34		35		36	
13													

A. Description of original monument and accessories and/or subsequent restoration:

- 1834 (Gov't. Land Office Notes) Harvey Parke, D.S.-Set post corner Sections 12&13-Pine 18 N14W 9; Cedar 10 S32 1/2 W 74
- 1976 (Survey-Liber 3 of Surveys, Page 412, Sanilac County) Irvin E. Chope, P.S. 6504-Fnd. 1/2" bar-Southeasterly\* 35.20' F.P.; Southerly\* 20.63' F.P.; (Note:"\*" indicates approximate bearing as per sketch shown on Survey Certificate by Chope)


B. Description of corner evidence found and/or method applied in restoring or reestablishing corner:

A - 5  
SW Corner Section 7 T12N-R12E  
Found Standard Concrete Mounment with Brass Cap  
North 2628.10 feet to the W 1/4 Corner Section 7  
South 2619.86 feet to the W 1/4 Corner Section 7  
Accepted as best evidence

APPROVED PEER BOARD MEETING  
July 20, 1999

C. Description of monument for corner and accessories established to perpetuate locating the position of the corner:

Found Standard Concrete Monument with 2" Brass Cap  
East, 21.62' Set 1/2" diameter reinforcing rod  
S04°W, 44.76' T.C. Re-mon. tag in West face of 3" Cherry  
S80°W, 90.06' T.C. Re-mon tag in South face of 14" Willow  
N16°W, 39.41' T.C. Re-mon. tag in East face of 3" Elm  
North, 1.0' "Survey Marker" witness post

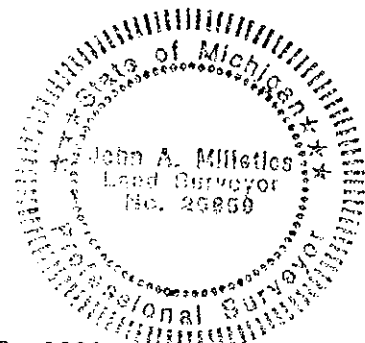

Signed by John A. Milletics  
Surveyor's Michigan License No. 25859

Date June 30, 1999