

SURVEY & REMONUMENTATION

SEP 17 1999

LIBER

2 PAGE 312

RECEIVED FOR RECORD

99 AUG -2 AM 9:10

SECTION

1999 REMONUMENTATION PROGRAM
LAND CORNER RECORDATION CERTIFICATE
 Filing Requirement of Act 74, Mich. P.A. 1970

LIBER NO. 2 PAGE NO. 312
 MICHELE VANNORMAN
 REGISTER OF DEEDS
 SANILAC CO., MICHIGAN

For corners in

<u>SANILAC</u> (County)	Located in:	Corner Code #
1. Public Land Survey	T12N R12E	A-10
	T ___ R ___	_____
	T ___ R ___	_____
	T ___ R ___	_____
2. Property Controlling in Section	S ___ T ___ R ___	_____
	S ___ T ___ R ___	_____
3. Miscellaneous Property in Sec.	S ___ T ___ R ___	_____
	S ___ T ___ R ___	_____

Register of Deeds Stamp & File Number

4. Lot No. _____, Recorded Plat _____
 5. Private Claims _____

I, John A. Milletica, in a field survey on April 1, 1999 do hereby state that under requirements of P.A. 74, Michigan P.A. of 1970, the corner points mentioned in lines 1 and 2 above were in conformance with regulations and rules therefore as required in the current manual of survey instructions of the United States Department of the Interior, Bureau of Land Management or by a decree of a Court of Law and for that the corner points mentioned in lines 3, 4 and 5 above were in conformance with the rules of the Michigan Board of Land Surveyors or by a Decree of a Court of Law; established, re-established, monumented, recovered, found as expressed below:

NOTE: Not more than 2 corners, all in the same town and range, may be recorded on this certificate.

A	B	C	D	E	F	G	H	I	J	K	L	M
1												
2	6	5	4	3	2	1						
3												
4	7	8	9	10	11	12						
5												
6	18	17	16	15	14	13						
7												
8	19	20	21	22	23	24						
9												
10	30	29	28	27	26	25						
11												
12	31	32	33	34	35	36						
13												

A. Description of original monument and accessories and/or subsequent restoration:

- 1834 (Gov't. Land Office Notes) Harvey Parke, D.S.-Set qr. Sec. post-Hemlock 8 S16W 25; Hemlock 6 N18 1/2 W 14
- 1976 (Survey-Liber 3, page 393, Sanilac County) Robert G. Kay, P.S. 14096-shows 1/2" Iron (does not indicate whether found or set)-N25°W 67.02' Nail in P.P.; S65°W 18.04' face road sign post; S55°E 38.39' Face Road Sign Post
- 1978 (Survey-Liber 4 of Surveys, page 118, Sanilac Co.) Robert G. Kay, P.S. 14096-shows 1/2" Bar at West 1/4 Corner of Sec. 30-accessories same as above Survey
- 1978 (Land Corner Recordation Certificate) David T. Rowe, P.S. 11192-Found 5/8" rerod; N40°W 66.72' RLS tag 11192 in PP; S60°W 18.17' Rd. sign post; S55°E 38.50' Rd. sign post; S60°E 56.75' Tele Box Post

B. Description of corner evidence found and/or method applied in restoring or reestablishing corner:


A - 10
 W 1/4 Corner Section 30 T12N-R12E
 Found Standard Concrete Monument with Brass Cap
 North 2614.64 feet to the NW Corner Section 30
 South 2631.00 feet to the SW Corner Section 30
 Acctped as best evidence

APPROVED PEER BOARD MEETING
 July 20, 1999

Jm

C. Description of monument for corner and accessories established to perpetuate locating the position of the corner:

Found Standard Monument w/2" Brass Cap
 North, 33.00' Found 1/2" reinforcing rod with cap 24593
 S52°E, 56.71' T.C. Re-mon. tag in North face of 4x4 post
 S40°W, 14.28' Set 1/2" reinforcing rod
 N30°W, 66.59' T.C. Re-mon. tag above fnd 11192 tag in Northeast face of power

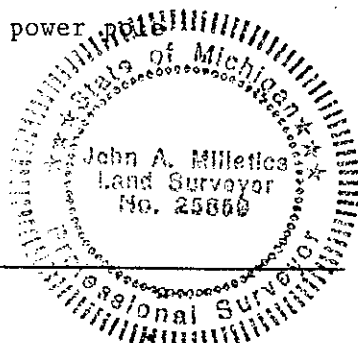

Signed by John A. Milletica
 Surveyor's Michigan License No. 25859

Date June 30, 1999