

SURVEY & REMONUMENTATION

LIBER

2 PAGE 314

RECEIVED FOR RECORD

SEP 17 1999

1999 REMONUMENTATION PROGRAM
LAND CORNER RECORDATION CERTIFICATE
 Filing Requirement of Act 74, Mich. P.A. 1970

99 AUG -2 AM 9:10

For corners in **SECTION**

BOOK NO. 2 PAGE NO. 314
 MICHELE VANNORMAN
 REGISTER OF DEEDS
 SANILAC CO., MICHIGAN

<u>SANILAC</u> (County)	Located In:	Corner Code #
1. Public Land Survey	T <u>12</u> N R <u>12</u> E	<u>A-12</u>
	T _____ R _____	_____
	T _____ R _____	_____
	T _____ R _____	_____
2. Property Controlling in Section	S _____ T _____ R _____	_____
	S _____ T _____ R _____	_____
3. Miscellaneous Property in Sec.	S _____ T _____ R _____	_____
	S _____ T _____ R _____	_____

Register of Deeds Stamp & File Number

4. Lot No. _____, Recorded Plat _____
 5. Private Claims _____

I, John A. Milletics, in a field survey on April 1, 19 99 do hereby state that under requirements of P.A. 74, Michigan P.A. of 1970, the corner points mentioned in lines 1 and 2 above were in conformance with regulations and rules therefore as required in the current manual of survey instructions of the United States Department of the Interior, Bureau of Land Management or by a decree of a Court of Law and /or that the corner points mentioned in lines 3, 4 and 5 above were in conformance with the rules of the Michigan Board of Land Surveyors or by a Decree of a Court of Law; established, re-established, monumented, recovered, found as expressed below:

NOTE: Not more than 2 corners, all in the same town and range, may be recorded on this certificate.

1	A	B	C	D	E	F	G	H	I	J	K	L	M	
2	6			5			4			3			2	1
3														
4	7			8			9			10			11	12
5														
6	10			17			16			15			14	13
7														
8	19			20			21			22			23	24
9														
10	30			29			28			27			26	25
11														
12	31			32			33			34			35	36
13														

- A. Description of original monument and accessories and/or subsequent restoration:
- 1834 (Gov't. Land Office Notes) Harvey Parke, D.S. -Set Qr. Sec. post-Lynn N41W 23 1/2; Beech 9 S62W 14
 - 1963 (Michigan State Highway Department Witness Card) Donald C. Pyle, P.S. 3165-Set 3/4" Iron rod N17°E 63.82' 14" Ash; S22°W 37.25' 15" Tw.Ash; N86°W 35.92' 24" Tri. Elm
 - 1973 (Survey-Liber 2 of Surveys, Page 76 Tuscola Co.) David T. Rowe, P.S. 11192-Fnd. 1" Iron Bar- N25°W 52.58' Nail in 6 1/2" Ash; S65°W 17.78' Nail in 6" Ash; N40°W 32.61' Road sign post
 - 1976 (Survey-Liber 3 of Surveys, pages 389&390, Sanilac County) Robert G. Kay, P.S. 14096-Fd. 1" iron bar-N25°W 52.58' Nail in 6" Ash; S65°W 17.78' Nail in 6" Ash; N40°W 32.61' Rd
 - 1978 (Land Corner Recordation Certificate) David T. Rowe, P.S. 11192-Fnd. 1" sq. Iron-S60°E 32.61' Rd. Sign Post; N15°E 106.75' RLS 11192 tag in 8" Ash; N45°W 33.00' Rd. sign post


B. Description of corner evidence found and/or method applied in restoring or reestablishing corner:

A - 12
 W 1/4 Corner Section 31 T12N-R12E
 Found Standard Concrete Monument with Brass Cap
 South 2623.24 feet to the SW Corner Section 31
 North 2627.90 feet to the NW Corner Section 31
 Accepted as best evidence

APPROVED PEER BOARD MEETING
 July 20, 1999

C. Description of monument for corner and accessories established to perpetuate locating the position of the corner:

Found Standard Concrete Monument with 2" Brass Cap
 N25°E, 50.29' set 1/2" reinforcing rod
 S45°E, 46.64' Found 3/8" diameter smooth iron bar
 S65°W, 31.76' T.C. Re-mon. tag in Northwest face of 8" Aspen
 N20°W, 61.66' T.C. Re-mon. tag in Southwest face of 6" Ash in clump of Ash

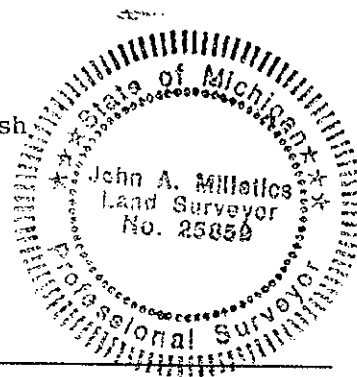

Signed by John A. Milletics
 Surveyor's Michigan License No. 25859

Date June 30, 1999