

JAN 19 2000

LIBER 2 PAGE 334

SECTION

1999 REMONUMENTATION PROGRAM
LAND CORNER RECORDATION CERTIFICATE
Filing Requirement of Act 74, Mich. P.A. 1970

RECEIVED FOR RECORD

99 NOV 30 AM 9:03

For corners in

<u>SANILAC</u> (County)	Located In:	Corner Code #
1. Public Land Survey	T 12N R 14E	A-4
	T ___ R ___	_____
	T ___ R ___	_____
	T ___ R ___	_____
2. Property Controlling in Section	S ___ T ___ R ___	_____
	S ___ T ___ R ___	_____
3. Miscellaneous Property in Sec.	S ___ T ___ R ___	_____
	S ___ T ___ R ___	_____

LIBER NO. 2 PAGE NO. 334
MICHELE VANNORMAN
REGISTER OF DEEDS
SANILAC CO. MICHIGAN

Register of Deeds Stamp & File Number

4. Lot No. _____, Recorded Plat _____
5. Private Claims _____

I, John A. Milletics, in a field survey on Aug. 2, 1999 do hereby state that under requirements of P.A. 74, Michigan P.A. of 1970, the corner points mentioned in lines 1 and 2 above were in conformance with regulations and rules therefore as required in the current manual of survey instructions of the United States Department of the Interior, Bureau of Land Management or by a decree of a Court of Law and /or that the corner points mentioned in lines 3, 4 and 5 above were in conformance with the rules of the Michigan Board of Land Surveyors or by a Decree of a Court of Law; established, re-established, monumented, recovered, found as expressed below:

NOTE: Not more than 2 corners, all in the same town and range, may be recorded on this certificate.

	A	B	C	D	E	F	G	H	I	J	K	L	M
1													
2		6		5		4		3		2		1	
3													
4		7		8		9		10		11		12	
5													
6		18		17		16		15		14		13	
7													
8		19		20		21		22		23		24	
9													
10		30		29		28		27		26		25	
11													
12		31		32		33		34		35		36	
13													

A. Description of original monument and accessories and/or subsequent restoration:

A-4 Hemlock 7 N39W 16; Birch 8 S 53 1/2 W 22
Old Survey Liber - None
L.C.R.C. - None
Act 132 - None
Unrecorded survey - Milletics dated Nov 1991

B. Description of corner evidence found and/or method applied in restoring or reestablishing corner:


A-4
W 1/4 Corner Section 7, T12N-R14E
Found 1/2" iron bar in gravel road bed 1' down
North 2687.92 feet to the NW Corner
South 2646.80 feet to the SW Corner
Accepted as best evidence

APPROVED PEER BOARD MEETING
NOV 19, 1999

gm

C. Description of monument for corner and accessories established to perpetuate locating the position of the corner:

A - 4
W 1/4 Corner Section 7 T12N-R14E
1/2" Iron Bar in Gravel Road Bed
North 2687.92 feet to the NW Corner
South 2646.80 feet to the SW Corner
East 27.11 feet to a nail in a Fence Post
S75°W 44.68 feet to a nail in a 12" Birch
S45°W 41.65 feet to a nail in a 8" Birch

 

Signed by *John A. Milletics*
Surveyor's Michigan License No. 25859

Date 11-15-99