REMONUMENTATION

JAN 19 2000

SECTION

LIBER 2 PAGE 342

1999 REMONUMENTATION PROGRAM
**LAND CORNER RECORDATION CERTIFICATE**
**Filing Requirement of Act 74, Mich. P.A. 1970**

RECEIVED FOR RECORD
99 NOV 30 AM 9:03
LIBER NO. 2 PAGE NO. 342
MICHELE VANNORMAN
REGISTER OF DEEDS
SANILAC CO., MICHIGAN

Register of Deeds Stamp & File Number

For corners in

SANILAC
(County)

| | Located In: | Corner Code # |
|---|---|---|
| 1. Public Land Survey | T12N R14E | A-12 |
| | T___ R___ | |
| | T___ R___ | |
| | T___ R___ | |
| 2. Property Controlling in Section | S___ T___ R___ | |
| | S___ T___ R___ | |
| 3. Miscellaneous Property in Sec. | S___ T___ R___ | |
| | S___ T___ R___ | |

4. Lot No. _____ , Recorded Plat _____
5. Private Claims _____

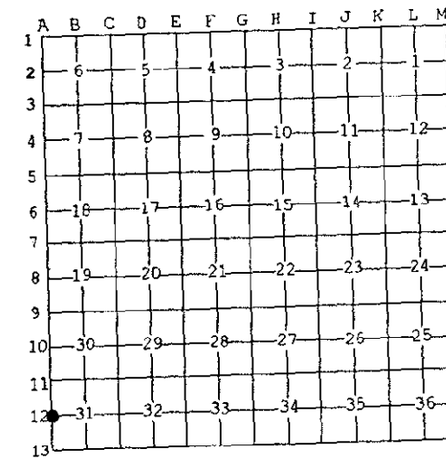


I, John A. Milletics, in a field survey on Aug. 2, 19 99 do hereby state that under requirements of P.A. 74, Michigan P.A. of 1970, the corner points mentioned in lines 1 and 2 above were in conformance with regulations and rules therefore as required in the current manual of survey instructions of the United States Department of the Interior, Bureau of Land Management or by a decree of a Court of Law and /or that the corner points mentioned in lines 3, 4 and 5 above were in conformance with the rules of the Michigan Board of Land Surveyors or by a Decree of a Court of Law; established, re-established, monumented, recovered, found as expressed below:

NOTE: Not more than 2 corners, all in the same town and range, may be recorded on this certificate.

A. Description of original monument and accessories and/or subsequent restoration:

A-12 B. Ash 30 N61W 39; Elm 11 S22W 39
Old Survey Liber - None
Act 132 - Liber 4 Page 765
L.C.R.C. - None
Unrecorded survey - Kay Eng Dated July 1978, Milletics Dated Nov 1994

B. Description of corner evidence found and/or method applied in restoring or reestablishing corner:

A-12
W1/4 Corner Seciton 31, T12N-R14E
Found 1/2" Iron Bar in gravel road Bed
North 2658.44 feet to the NW Corner
South 2652.07 feet to the SW Corner
Accpeted as best evidence

APPROVED PEER BOARD MEETING
NOV 19, 1999

C. Description of monument for corner and accessories established to perpetuate locating the position of the corner:

A - 12
W 1/4 Corner Section 31 T12N-R14E
1/2" Iron Bar in gravel road bed with cap
North 2658.44 feet to the NW Corner
South 2652.07 feet to the SW Corner
West 42.89 feet to the NE Corner of a Bell Riser Box
S85°W 35.14 feet to a nail in a 12" Pine
S45°W 52.90 feet to a nail in a 18" Pine
S30°W 71.92 feet to a nail in a 18" Pine

Signed by _____ Date 11-15-1999
Surveyor's Michigan License No. 25859

FORM APPROVED BY MICHIGAN STATE BOARD OF PROFESSIONAL SURVEYORS, JAN. 28, 1971
REVISED MAY 14, 1975
REVISED JAN., 1983
REVISED OCT., 1995