

SEP 20 2000

LIBER 3 PAGE 31

RECEIVED FOR RECORD

2000 REMONUMENTATION PROGRAM LAND CORNER RECORDATION CERTIFICATE Filing Requirement of Act 74, Mich. P.A. 1970

00 JUN 13 AM 11:56

SECTION

LIBER NO. 3 PAGE NO. 3 MICHELE VANNORMAN REGISTER OF DEEDS SANILAC CO., MICHIGAN

For corners in

Table with columns: Sanilac (County), Located In, Corner Code #. Rows include Public Land Survey, Property Controlling in Section, and Miscellaneous Property in Sec.

Register of Deeds Stamp & File Number

4. Lot No. , Recorded Plat
5. Private Claims

2000

I, John A Millettics, in a field survey on March 29, 2000 do hereby state that under requirements of P.A. 74, Michigan P.A. of 1970, the corner points mentioned in lines 1 and 2 above were in conformance with regulations and rules therefore as required in the current manual of survey instructions of the United States Department of the Interior, Bureau of Land Management or by a decree of a Court of Law and/or that the corner points mentioned in lines 3, 4 and 5 above were in conformance with the rules of the Michigan Board of Land Surveyors or by a Decree of a Court of Law; established, re-established, monumented, recovered, found as expressed below:

NOTE: Not more than 2 corners, all in the same town and range, may be recorded on this certificate.


Grid table with columns A-M and rows 1-13. A dot is marked at row 7, column D.

A. Description of original monument and accessories and/or subsequent restoration:

- D - 7 GLO Notes
Tamarack 10" N85°W 6 Links
Pine 10" N75°E 6 Links
OLD Survey Liber - M.E. Ward Dec. 1896 - Thomas Nicol May 1902
L.C.R.C. - None
Act 132 - Irvin Choep Liber 1 Page 570, Kay Eng Liber 1 Page 46
Irvin Choep Liber 1 Page 130

B. Description of corner evidence found and/or method applied in restoring or reestablishing corner:

- D - 7
S 1/4 Corner Section 17 T12N-R14E
Found 1/2" Iron in Monu Box 1'± North of Pavement Centerline
West 2692.40 feet to the SW Corner Section 17
East 2692.40 feet to the SE Corner Section 17
Accpeted as best evidence

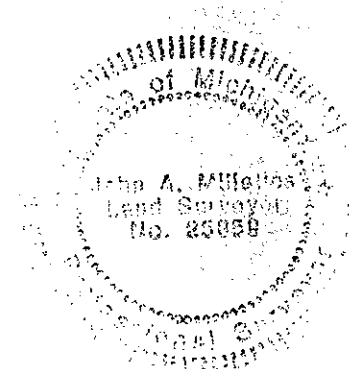

C. Description of monument for corner and accessories established to perpetuate locating the position of the corner:

- D - 7
S 1/4 Corner Section 17 T12N-R14E
1/2" Iron in Moun Box with cap
N45°W 64.55 feet to a nail in a Wooden Fence Post
N60°E 78.70 feet to the SW Corner of a Bell Riser Box
S45°E 81.80 feet to a nail in a Power Pole
S10°W 60.80 feet to a nail in a 9" Pine
West 2692.40 feet to the SW Corner Section 17
East 2692.40 feet to the SE Corner Section 17

APPROVED PEER BOARD MEETING JUNE 12, 2000

Handwritten signature/initials

Signed by John A. Millettics
Surveyor's Michigan License No. 25859

Date April 11, 2000