

SURVEY & REMONUMENTATION

APR 14 1998

REMONUMENTATION SECTION

LIBER

2 PAGE 176

LAND CORNER RECORDATION CERTIFICATE
Filing Requirement of Act 74, Mich. P.A. 1970

RECEIVED FOR RECORD
97 DEC -2 AM 9:10
LIBER NO. 2 PAGE NO. 176
ESTHER LEE
REGISTER OF DEEDS
SANILAC CO., MICHIGAN

For corners in Custer Township

Sanilac (County)	Located In:	Corner Code #
1. Public Land Survey	T12NR14E	E - 1
	T___R___	_____
	T___R___	_____
	T___R___	_____
2. Property Controlling in Section	S___T___R___	_____
	S___T___R___	_____
3. Miscellaneous Property in Sec.	S___T___R___	_____
	S___T___R___	_____

SURVEY & REMONUMENTATION

JAN 08 1998

SECTION

Register of Deeds Stamp & File Number

4. Lot No. _____, Recorded Plat _____
5. Private Claims _____

I, John A Milletics, in a field survey on July 22, 1997, do hereby state that under requirements of P.A. 74, Michigan P.A. of 1970, the corner points mentioned in lines 1 and 2 above were in conformance with regulations and rules therefore as required in the current manual of survey instructions of the United States Department of the Interior, Bureau of Land Management or by a decree of a Court of Law and/or that the corner points mentioned in lines 3, 4 and 5 above were in conformance with the rules of the Michigan Board of Land Surveyors or by a Decree of a Court of Law, established, re-established, monumented, recovered, found as expressed below:

NOTE: Not more than 2 corners, all in the same town and range, may be recorded on this certificate.

	A	B	C	D	E	F	G	H	I	J	K	L	M
1													
2	6			5		4		3		2		1	
3													
4	7			8		9		10		11		12	
5													
6	18			17		16		15		14		13	
7													
8	19			20		21		22		23		24	
9													
10	30			29		28		27		26		25	
11													
12	31			32		33		34		35		36	
13													

A. Description of original monument and accessories and/or subsequent restoration:

E - 1

GLO Notes

Set Post Corner
Beech 8 S58°E 15
Beech 30 S34°W 20

Old Survey Liber, Survey dated Oct 1910 by Nicol
Act 74 None
Act 132 Liber 4 Page 282

B. Description of corner evidence found and/or method applied in restoring or reestablishing corner:

E - 1


Found Monu Box in place with 5/8" Iron Bar

APPROVED PEER BOARD MEETING
NOV. 26, 1997 *JM*

C. Description of monument for corner and accessories established to perpetuate locating the position of the corner:

E - 1

NE Corner Section 5 T12N-R14E Custer Twp.
Monu Box in place with 5/8" iron bar
East 10.56 feet to a Monu Box
S50W 39.38 feet to a Stop Sign
N50E 69.10 feet to a nail in a 24" Pine
N60E 86.90 feet to a nail in a 24" Pine
S45E 58.98 feet to a nail in a Power Pole
South 2910.40 feet to the E 1/4 Corner Section 5

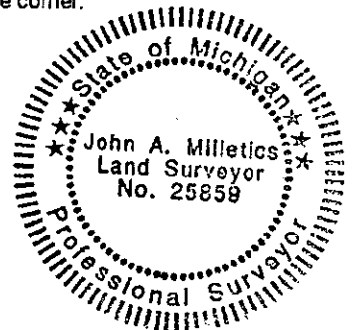

Signed by John A. Milletics
Surveyor's Michigan License No. 25859

Date Nov 12, 1997