

APR 14 1998

LIBER 2 PAGE 178

SECTION REMONUMENTATION

LAND CORNER RECORDATION CERTIFICATE Filing Requirement of Act 74, Mich. P.A. 1970

For corners in CUSTER TOWNSHIP

Sanilac (County)	Located In:	Corner Code #
1. Public Land Survey	T12NR14E	E - 3
	T R	
	T R	
	T R	
	T R	
2. Property Controlling in Section	S T R	
	S T R	
3. Miscellaneous Property in Sec.	S T R	
	S T R	

RECEIVED FOR RECORD
 97 DEC -2 AM 9:10
 LIBER NO. 2 PAGE NO. 178
 ESTHER LEE
 REGISTER OF DEEDS
 SANILAC CO., MICHIGAN

SURVEY & REMONUMENTATION

JAN 08 1998

SECTION

Register of Deeds Stamp & File Number

4. Lot No. _____, Recorded Plat _____
 5. Private Claims _____

I, John A Milletics, in a field survey on July 21, 1997 do hereby state that under requirements of P.A. 74, Michigan P.A. of 1970, the corner points mentioned in lines 1 and 2 above were in conformance with regulations and rules therefore as required in the current manual of survey instructions of the United States Department of the Interior, Bureau of Land Management or by a decree of a Court of Law and for that the corner points mentioned in lines 3, 4 and 5 above were in conformance with the rules of the Michigan Board of Land Surveyors or by a Decree of a Court of Law; established, re-established, monumented, recovered, found as expressed below:

NOTE: Not more than 2 corners, all in the same town and range, may be recorded on this certificate.

	A	B	C	D	E	F	G	H	I	J	K	L	M
1													
2	6			5			4		3		2		1
3					•								
4	7			8			9		10		11		12
5													
6	18			17			16		15		14		13
7													
8	19			20			21		22		23		24
9													
10	30			29			28		27		26		25
11													
12	31			32			33		34		35		36
13													

A. Description of original monument and accessories and/or subsequent restoration:

E - 3

GLO Notes

Set Post Corner
 Birch 9 N53°W 15
 Hemlock 10 N48°E 17

Old Survey Liber, survey dated March 1894 by Galbraith, survey dated April 1895 by Ward, survey dated Oct 1910 by Nicol
 Act 74 None
 Act 132 Liber 3 Page 29

B. Description of corner evidence found and/or method applied in restoring or reestablishing corner:

E - 4


Found Monu Box with 5/8" Iron Bar

APPROVED PEER BOARD MEETING
 NOV. 26, 1997 *[Signature]*

C. Description of monument for corner and accessories established to perpetuate locating the position of the corner:

E - 3

NE Cor Section 8 T12N-R14E Custer Twp.
 Moun Box in place with 5/8" Iron Bar
 N45°W 66.55 feet to a nail in a Telephone Pole
 N45°E 68.72 feet to a nail in a Power Pole
 S45°E 76.18 feet to a nail in a Power Pole
 S45°W 61.06 feet to a nail in a Telephone Pole
 South 2664.70 feet to the E 1/4 Cor Section 8
 North 2639.92 feet to the E 1/4 Cor Section 5

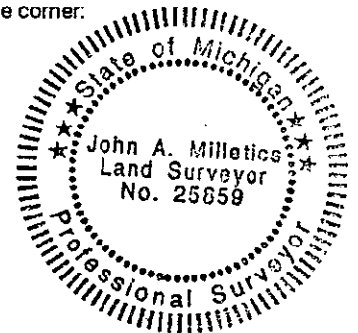

Signed by *[Signature]*
 Surveyor's Michigan License No. 25859

Date Nov 12, 1997