

APR 14 1998

SECTION REMONUMENTATION

LIBER

2 PAGE 181

RECEIVED FOR RECORD

LAND CORNER RECORDATION CERTIFICATE Filing Requirement of Act 74, Mich. P.A. 1970

97 DEC -2 AM 9:11

LIBER NO. 2 PAGE NO. 181

ESTHER LEE REGISTER OF DEEDS SANILAC CO. MICHIGAN SURVEY & REMONUMENTATION

JAN 08 1998

SECTION

Register of Deeds Stamp & File Number

For corners in CUSTER TOWNSHIP

Table with columns: Sanilac (County), Located In, Corner Code #. Rows include Public Land Survey, Property Controlling in Section, and Miscellaneous Property in Sec.

4. Lot No. , Recorded Plat
5. Private Claims

I, John A Milletics, in a field survey on July 15, 19 97 do hereby state that under requirements of P.A. 74, Michigan P.A. of 1970, the corner points mentioned in lines 1 and 2 above were in conformance with regulations and rules therefore as required in the current manual of survey instructions of the United States Department of the Interior, Bureau of Land Management or by a decree of a Court of Law and /or that the corner points mentioned in lines 3, 4 and 5 above were in conformance with the rules of the Michigan Board of Land Surveyors or by a Decree of a Court of Law, established, re-established, monumented, recovered, found as expressed below:

NOTE: Not more than 2 corners, all in the same town and range, may be recorded on this certificate.

Grid table with columns A-M and rows 1-13. Cell (6, D) contains a dot.

A. Description of original monument and accessories and/or subsequent restoration:

E - 6
GLO Notes
Set 1/4 Section Post Old Survey Liber, survey dated Dec. 1896 by
Black Ash 10" in Dia is Post Ward
Act 74 None
Act 132 Liber 4 Page 54
Liber 4 Page 474


B. Description of corner evidence found and/or method applied in restoring or reestablishing corner:

E - 6
Found Monu Box with 5/8" Iron bar

APPROVED PEER BOARD MEETING
NOV. 26, 1997

C. Description of monument for corner and accessories established to perpetuate locating the position of the corner:

E - 6
E 1/4 Corner Section 17 T12N-R14E Custer Twp.
Monu Box in place with 5/8" Iron Bar
N45°W 54.96 feet to a nail in a Power Pole
N50°E 40.94 feet to a stop sign
S45°E 87.50 feet to a nail in a Power Pole
S50°W 37.04 feet to a stop sign
North 2675.64 feet to the NE Corner Section 17
South 2675.64 feet to the SE Corner Section 17

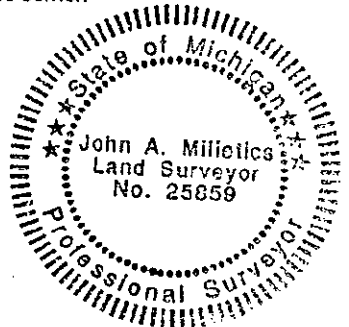

Signed by [Signature]
Surveyor's Michigan License No. 25859

Date Nov 12, 1997