

SURVEY & REMONUMENTATION

APR 14 1998

SECTION REMONUMENTATION

LIBER 2 PAGE 186

RECEIVED FOR RECORD

97 DEC -2 AM 9:11

LAND CORNER RECORDATION CERTIFICATE Filing Requirement of Act 74, Mich. P.A. 1970

LIBER NO. 2 PAGE NO. 186 ESTHER LEE REGISTER OF DEEDS SANILAC CO. MICHIGAN

For corners in CUSTER TOWNSHIP

Table with columns: Sanilac (County), Located In, Corner Code #. Rows include Public Land Survey, Property Controlling in Section, and Miscellaneous Property in Sec.

SURVEY & REMONUMENTATION

JAN 08 1998

Register of Deeds Stamp & File Number

4. Lot No. , Recorded Plat
5. Private Claims

I, John A Milletics, in a field survey on July 14, 1997 do hereby state that under requirements of P.A. 74, Michigan P.A. of 1970, the corner points mentioned in lines 1 and 2 above were in conformance with regulations and rules therefore as required in the current manual of survey instructions of the United States Department of the Interior, Bureau of Land Management or by a decree of a Court of Law and/or that the corner points mentioned in lines 3, 4 and 5 above were in conformance with the rules of the Michigan Board of Land Surveyors or by a Decree of a Court of Law; established, re-established, monumented, recovered, found as expressed below:

Grid table with columns A-M and rows 1-13. A dot is marked at the intersection of column E and row 11.

NOTE: Not more than 2 corners, all in the same town and range, may be recorded on this certificate.

A. Description of original monument and accessories and/or subsequent restoration:

E - 11

GLO Notes

Set Post Corner
Birch 10 N52°E 6
Hemlock 10 S52°W 10

Old Survey Liber, survey dated April 1894 by Galbraith & survey dated Aug 1906 by Nicol Act 74 None Act 132 Liber 4 Page 344 Condo recorded Liber 502

B. Description of corner evidence found and/or method applied in restoring or reestablishing corner:

E - 11


Found Monu Box with iron

APPROVED PEER BOARD MEETING NOV. 26, 1997

C. Description of monument for corner and accessories established to perpetuate locating the position of the corner:

E - 11

NE Corner Section 32 T12N-R14E Custer Twp. Monu Box with iron and cap N45°E 61.40 feet to a nail in a Power Pole N70°W 88.37 feet to a nail in a 24" Pine S50°W 34.33 feet to a stop sign S45°E 79.00 to a nail in a 30" Maple South 2634.70 feet to the E 1/4 Cor Section 32 North 2664.22 feet to the E 1/4 Cor Section 29

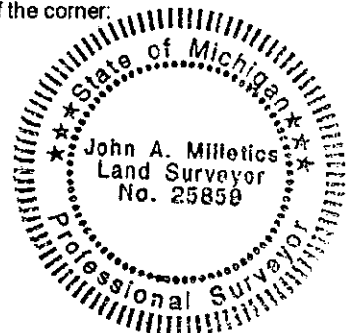

Signed by [Signature] Surveyor's Michigan License No. 25859

Date Nov 12, 1997