

SURVEY & REMONUMENTATION

APR 14 1998

SECTION REMONUMENTATION

LIBER 2 PAGE 187

LAND CORNER RECORDATION CERTIFICATE
Filing Requirement of Act 74, Mich. P.A. 1970

RECEIVED FOR RECORD

97 DEC -2 AM 9:11

LIBER NO. 2 PAGE NO. 187

ESTHER LEE
REGISTER OF DEEDS
SANILAC CO., MICHIGAN

SURVEY & REMONUMENTATION

JAN 08 1998

SECTION

Register of Deeds Stamp & File Number

For corners in CUSTER TOWNSHIP

Sanilac
(County)

Located in:

Corner Code #

1. Public Land Survey	T 12NR 14E	E - 12
	T R	
	T R	
	T R	
2. Property Controlling in Section	S T R	
	S T R	
3. Miscellaneous Property in Sec.	S T R	
	S T R	

4. Lot No. _____, Recorded Plat _____
5. Private Claims _____

I, John A Millettics in a field survey on JULY 14, 1997 do hereby state that under requirements of P.A. 74, Michigan P.A. of 1970, the corner points mentioned in lines 1 and 2 above were in conformance with regulations and rules therefore as required in the current manual of survey instructions of the United States Department of the Interior, Bureau of Land Management or by a decree of a Court of Law and/or that the corner points mentioned in lines 3, 4 and 5 above were in conformance with the rules of the Michigan Board of Land Surveyors or by a Decree of a Court of Law; established, re-established, monumented, recovered, found as expressed below:

NOTE: Not more than 2 corners, all in the same town and range, may be recorded on this certificate.

A	B	C	D	E	F	G	H	I	J	K	L	M
1												
2	6		5		4		3		2		1	
3												
4	7		8		9		10		11		12	
5												
6	16		17		16		15		14		13	
7												
8	19		20		21		22		23		24	
9												
10	30		29		28		27		26		25	
11												
12	31		32		33		34		35		36	
13												

A. Description of original monument and accessories and/or subsequent restoration:

E - 12

GLO Notes

Set 1/4 Section Post
Birch 9 N52°W 21
B.Ash 10 N58°E 14

Old Survey Liber None
Act 74 None
Act 132 Liber 4 Page 344
Condo recorded Liber 502

B. Description of corner evidence found and/or method applied in restoring or reestablishing corner:

E - 12


Found "v" Bar 6" under blacktop surface

APPROVED PEER BOARD MEETING
NOV. 26, 1997

C. Description of monument for corner and accessories established to perpetuate locating the position of the corner:

E - 12

W 1/4 Corner Section 33 T12N-R14E Custer Twp.
Monu Box with 1/2" Iron bar and cap
N45°E 55.71 feet to a nail in a 48" Maple
N50°E 39.65 feet to a fire hydrant
S40°E 63.04 feet to a nail in a 36" Ash
S30°W 56.99 feet to a nail in a 48" Maple
N70°W 25.00 feet to a nail in a 48" Maple
North 2634.70 feet to the NW Corner Section 34

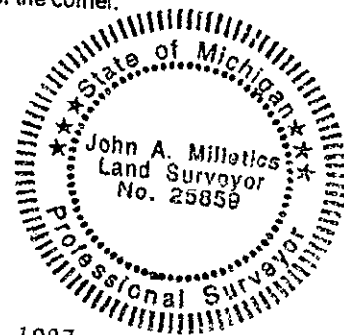

Signed by John A. Millettics

Date Nov 11, 1997

Surveyor's Michigan License No. 25859