

SURVEY & REMONUMENTATIO

LIBER 3 PAGE 10

SEP 20 2000

2000 REMONUMENTATION PROGRAM
LAND CORNER RECORDATION CERTIFICATE
Filing Requirement of Act 74, Mich. P.A. 1970

RECEIVED FOR RECORD

00 JUN 13 AM 11:57

SECTION

For corners in

| | | |
|------------------------------------|-------------|---------------|
| <u>Sanilac</u> (County) | Located In: | Corner Code # |
| 1. Public Land Survey | T12N R14E | L - 7 |
| | T R | |
| | T R | |
| | T R | |
| 2. Property Controlling in Section | S T R | |
| | S T R | |
| 3. Miscellaneous Property in Sec. | S T R | |
| | S T R | |

LIBER NO. 3 PAGE NO. 10
MICHELE VAHORNAN
REGISTER OF DEEDS
SANILAC CO., MICHIGAN

Register of Deeds Stamp & File Number

4. Lot No. _____, Recorded Plat _____
5. Private Claims _____

I, John A Milletics, in a field survey on March 29, 2000 do hereby state that under requirements of P.A. 74, Michigan P.A. of 1970, the corner points mentioned in lines 1 and 2 above were in conformance with regulations and rules therefore as required in the current manual of survey instructions of the United States Department of the Interior, Bureau of Land Management or by a decree of a Court of Law and/or that the corner points mentioned in lines 3, 4 and 5 above were in conformance with the rules of the Michigan Board of Land Surveyors or by a Decree of a Court of Law; established, re-established, monumented, recovered, found as expressed below:

NOTE: Not more than 2 corners, all in the same town and range, may be recorded on this certificate.

| | | | | | | | | | | | |
|----|----|----|----|----|----|----|---|---|---|---|---|
| A | B | C | D | E | F | G | H | I | J | K | L |
| 1 | | | | | | | | | | | |
| 2 | 6 | 5 | 4 | 3 | 2 | 1 | | | | | |
| 3 | | | | | | | | | | | |
| 4 | 7 | 8 | 9 | 10 | 11 | 12 | | | | | |
| 5 | | | | | | | | | | | |
| 6 | 18 | 17 | 16 | 15 | 14 | 13 | | | | | |
| 7 | | | | | | | | | | | |
| 8 | 19 | 20 | 21 | 22 | 23 | 24 | | | | | |
| 9 | | | | | | | | | | | |
| 10 | 30 | 29 | 28 | 27 | 26 | 25 | | | | | |
| 11 | | | | | | | | | | | |
| 12 | 31 | 32 | 33 | 34 | 35 | 36 | | | | | |
| 13 | | | | | | | | | | | |

A. Description of original monument and accessories and/or subsequent restoration:


GLO Notes
A 10" B. Ash in Occupying Corner
Old Survey Liber M.E. Ward April 1896
Act 132 - None
Unrecorded Survey - Milletics June 1997 -

B. Description of corner evidence found and/or method applied in restoring or reestablishing corner:

L - 7
N 1/4 Corner Section 24 T12N-R14E
Found 1/2" Iron Bar in Gravel Road Bed
West 2657.30 feet to the NW Corner
East 2657.30 feet to the NE Corner
Accepted as best evidence

C. Description of monument for corner and accessories established to perpetuate locating the position of the corner:

L - 7
N 1/4 Corner Section 24 T12N-R14E
1/2" Iron Bar in Gravel Road Bed
N30°W 26.70 feet to the North end of a 48" CMP
S30°W 24.70 feet to the South end of a 48' CMP
N45°W 45.20 feet to the SE Corner of a Large Rock
West 2657.30 feet to the NW Corner
East 2657.30 feet to the NE Corner

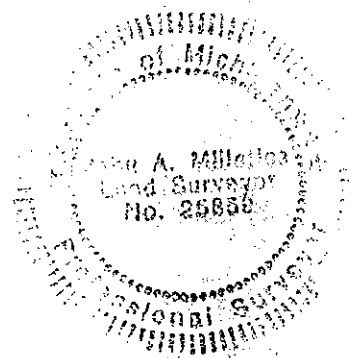

APPROVED PEER BOARD
MEETING JUNE 12, 2000

jm

Signed by John A Milletics
Surveyor's Michigan License No. 25859

Date May 8, 2000