

SURVEY & REMONUMENTATIO

SEP 20 2000

LIBER 3 PAGE 11

RECEIVED FOR RECORD

00 JUN 13 AM 11:57

2000 REMONUMENTATION PROGRAM LAND CORNER RECORDATION CERTIFICATE Filing Requirement of Act 74, Mich. P.A. 1970

LIBER NO. 3 PAGE NO. 11 NICHELE VANORMAN REGISTER OF DEEDS SANILAC CO., MICHIGAN

SECTION

For corners in

Sanilac (County)	Located In:	Corner Code #
1. Public Land Survey	T12N R14E	M - 7
	T R	
	T R	
	T R	
2. Property Controlling in Section	S T R	
	S T R	
3. Miscellaneous Property in Sec.	S T R	
	S T R	

Register of Deeds Stamp & File Number

4. Lot No. , Recorded Plat
5. Private Claims

2000

I, John A Milletics, in a field survey on March 29, 2000 do hereby state that under requirements of P.A. 74, Michigan P.A. of 1970, the corner points mentioned in lines 1 and 2 above were in conformance with regulations and rules therefore as required in the current manual of survey instructions of the United States Department of the Interior, Bureau of Land Management or by a decree of a Court of Law and /or that the corner points mentioned in lines 3, 4 and 5 above were in conformance with the rules of the Michigan Board of Land Surveyors or by a Decree of a Court of Law; established, re-established, monumented, recovered, found as expressed below:

NOTE: Not more than 2 corners, all in the same town and range, may be recorded on this certificate.

	A	B	C	D	E	F	G	H	I	J	K	L
1												
2	6		5		4		3		2		1	
3												
4	7		8		9		10		11		12	
5												
6	18		17		16		15		14		13	
7												
8	19		20		21		22		23		24	
9												
10	30		29		28		27		26		25	
11												
12	31		32		33		34		35		36	
13												

A. Description of original monument and accessories and/or subsequent restoration:

GLO Notes

Maple 8" N51°W 14.5 Links
Maple 8" S61°W 2.5 Links

Act 132 - None

Old Survey Liber - M.E. Ward April 1896

Unrecorded Survey - Milletics June 1997

B. Description of corner evidence found and/or method applied in restoring or reestablishing corner:


M - 7

NE Corner Section 24 T12N-R14E

Found P.K. Nail 1' West of West edge of Bridge Deck

West 2657.30 feet to the N 1/4 Corner

Accepted as best evidence

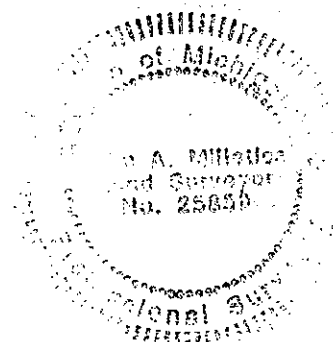

C. Description of monument for corner and accessories established to perpetuate locating the position of the corner:

M - 7

NE Corner Section 24 T12N-R14E

1/2" Iron Bar with Cap

N10°W 16.65 feet to the SE Corner of a Concrete Pillar

S10°E 18.50 feet to the NW Corner of a Concrete Pillar

N30°E 19.40 feet to the SW Corner of the 5th Concrete Pillar

S30°W 22.20 feet to a nail in a Wooden Guard Rail Post

West 2657.30 feet to the N 1/4 Corner

APPROVED PEER BOARD MEETING JUNE 12, 2000

Signed by John A Milletics
Surveyor's Michigan License No. 25859

Date May 8, 2000