

THIS LAND CORNER IS BEING RE-RECORDED TO CORRECT RANGE NUMBER ON RECORDING IN LIBER 3 PAGE 4.
 2000 REMONUMENTATION PROGRAM
 LAND CORNER RECORDATION CERTIFICATE
 Filing Requirement of Act 74, Mich. P.A. 1970

corners in

Sanilac (County)	Located In:	Corner Code #
Public Land Survey	T <u>12</u> N R <u>14</u> E	F - 7
	T <u> </u> R <u> </u>	<u> </u> - <u> </u>
	T <u> </u> R <u> </u>	<u> </u> - <u> </u>
	T <u> </u> R <u> </u>	<u> </u> - <u> </u>
Property Controlling in Section	S <u> </u> T <u> </u> R <u> </u>	<u> </u> - <u> </u>
Miscellaneous Property in Sec.	S <u> </u> T <u> </u> R <u> </u>	<u> </u> - <u> </u>
	S <u> </u> T <u> </u> R <u> </u>	<u> </u> - <u> </u>

Seq. 2

RECEIVED FOR RECORD

00 NOV 20 AM 8:42

LIBER NO. _____ PAGE NO. _____
 NICHELE VANHOANAN
 REGISTER OF DEEDS
 SANILAC CO. MICHIGAN

Register of Deeds Stamp & File Number

Lot No. _____, Recorded Plat _____
 Private Claims _____

John A. Milletics, in a field survey on March 29, 2000 do hereby state that under requirements of P.A. 74, Michigan P.A. of 1970, the corner points mentioned in lines 1 and 2 above were in accordance with regulations and rules therefore as required in the current manual of survey instructions of the United States Department of the Interior, Bureau of Land Management or by a decree of a Court of Law and for the corner points mentioned in lines 3, 4 and 5 above were in conformance with the rules of the Michigan Board of Land Surveyors or by a Decree of a Court of Law; established, re-established, monumented, surveyed, covered, found as expressed below:

NOTE: Not more than 2 corners, all in the same town and range, may be recorded on this certificate.

	A	B	C	D	E	F	G	H	I	J	K	L	M
1													
2	6		5		4		3		2		1		
3													
4	7		8		9		10		11		12		
5													
6	18		17		16		15		14		13		
7													
8	19		20		21		22		23		24		
9													
10	30		29		28		27		26		25		
11													
12	31		32		33		34		35		36		
13													


Description of original monument and accessories and/or subsequent restoration:

- F - 7 GLO Notes
- Black Ash 9" S55°W10 Links
- Black Ash 10" N16°E 18 Links
- OLD Survey Liber - M.E. Ward Dec. 1896 - Thomas Nicol May 1902
- Act 132 - None
- L.C.R.C. - None
- Unrecorded Surveys Dated - Milletics April 1986, Milletics Jan. 1991
- Milletics Oct. 1994

SURVEY & MONUMENTATION
 JAN 22 2001
 SECTION

Description of corner evidence found and/or method applied in restoring or reestablishing corner:

- F - 7 S 1/4 Corner Section 16
- Found 1/2" Iron in Gravel Road Bed
- West 2657.48 Feet to the SW Corner Section 16
- East 2657.48 Feet to the SE Corner Section 16
- Accepted as best evidence

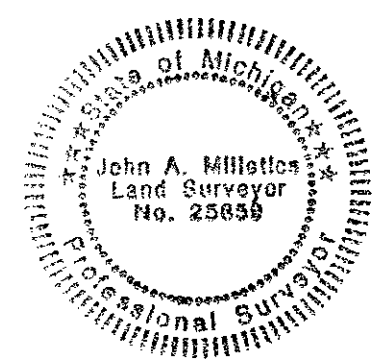

Description of monument for corner and accessories established to perpetuate locating the position of the corner:

- F - 7 S 1/4 Corner Section 16 T12N-R14E,
- 1/2" Iron Bar with cap in gravel road bed
- South 32.85 Feet to a 1/2" Iron Bar
- 310°E 18.70 Feet to a nail in a 30" Ash
- 345°W 76.80 Feet to a nail in a 24" Ash
- 375°E 84.50 Feet to a nail in a 24" Ash
- West 2657.48 Feet to the SW Corner Section 16
- East 2657.48 Feet to the SE Corner Section 16

APPROVED PEER BOARD
 MEETING JUNE 12, 2000

21

Recorded by John A. Milletics
 Surveyor's Michigan License No. 25859

Date April 11, 2000