

SEP 20 2000

LIBER 3 PAGE 12

RECEIVED FOR RECORD

00 JUN 13 AM 11:57

LIBER NO. 3 PAGE NO. 12  
MICHELE VAHORNAN  
REGISTER OF DEEDS  
SANILAC CO., MICHIGAN

2000 REMONUMENTATION PROGRAM  
LAND CORNER RECORDATION CERTIFICATE  
Filing Requirement of Act 74, Mich. P.A. 1970

SECTION

For corners in

Sanilac

(County)

Located In:

Corner Code #

- 1. Public Land Survey T12N R15E A -7
- T R
- T R
- T R
- 2. Property Controlling S T R
- in Section S T R
- 3. Miscellaneous S T R
- Property in Sec. S T R

Register of Deeds Stamp & File Number

- 4. Lot No. \_\_\_\_\_, Recorded Plat \_\_\_\_\_
- 5. Private Claims \_\_\_\_\_

I, John A Milletics, in a field survey on May 1, 2000 do hereby state that under requirements of P.A. 74, Michigan P.A. of 1970, the corner points mentioned in lines 1 and 2 above were in conformance with regulations and rules therefore as required in the current manual of survey instructions of the United States Department of the Interior, Bureau of Land Management or by a decree of a Court of Law and /or that the corner points mentioned in lines 3, 4 and 5 above were in conformance with the rules of the Michigan Board of Land Surveyors or by a Decree of a Court of Law; established, re-established, monumented, recovered, found as expressed below:

NOTE: Not more than 2 corners, all in the same town and range, may be recorded on this certificate.

1	A	B	C	D	E	F	G	H	I	J	K	L	I
2		6		5		4		3		2		1	
3													
4		7		8		9		10		11		12	
5													
6		18		17		16		15		14		13	
7													
8		19		20		21		22		23		24	
9													
10		30		29		28		27		26		25	
11													
12		31		32		33		34		35		36	
13													

A. Description of original monument and accessories and/or subsequent restoration:

GLO Notes

- Maple 8" N51°W 14½ Links
- Maple 8" s61°W 2½ Links

Old Survey Liber - None


LCRC - None

Act 132 - Irvin Chope Liber 1 Page 552, Irvin Chope Liber 1 Page 614  
Irvin Chope Liber 2 Page 276, Irvin Chope Liber 3, Page 602

B. Description of corner evidence found and/or method applied in restoring or reestablishing corner:

A - 7

SW Corner Section 18 T12N-R15E  
Found P.K. Nail 1' West of West edge of Bridge Deck  
West 2657.30 feet to S 1/4 Corner  
East 2606.32 feet to S 1/4 Corner  
Accepted as best evidence

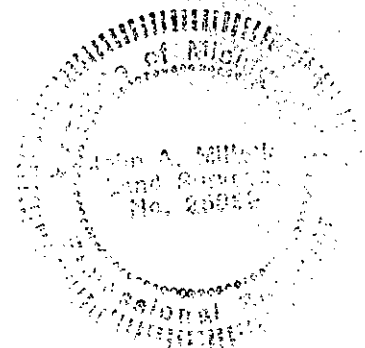

C. Description of monument for corner and accessories established to perpetuate locating the position of the corner:

A - 7

SW Corner Section 18 T12N-R15E  
1/2" Iron Bar with Cap  
N10°W 16.65 feet to the SE Corner of a Concrete Pillar  
S10°E 18.50 feet to the NW Corner of a Concrete Pillar  
N30°E 19.40 feet to the SW Conrer of the 5th Concrete Pillar  
S30°W 22.20 feet to a nail in a Wooden Guard Rail Post  
West 2657.30 feet to the S 1/4 Corner  
East 2606.32 feet to the S 1/4 Corner

APPROVED PEER BOARD  
MEETING JUNE 12, 2000

Signed by John A Milletics  
Surveyor's Michigan License No. 25859

Date June 3, 2000