

SEP 26 2000

LIBER 3 PAGE 13

SECTION

2000 REMONUMENTATION PROGRAM  
LAND CORNER RECORDATION CERTIFICATE  
Filing Requirement of Act 74, Mich. P.A. 1970

RECEIVED FOR RECORD

00 JUN 13 AM 11:57

LIBER NO. 3 PAGE NO. 13  
MICHELE VANNORMAN  
REGISTER OF DEEDS  
SARILAC CO. MICHIGAN

For corners in

<u>Sanilac</u> (County)	Located In:	Corner Code #
1. Public Land Survey	T12N R15E	B - 7
	T___ R___	_____
	T___ R___	_____
	T___ R___	_____
2. Property Controlling in Section	S___ T___ R___	_____
	S___ T___ R___	_____
3. Miscellaneous Property in Sec.	S___ T___ R___	_____
	S___ T___ R___	_____

Register of Deeds Stamp & File Number

4. Lot No. \_\_\_\_\_, Recorded Plat \_\_\_\_\_  
 5. Private Claims \_\_\_\_\_

I, John A Milletics, in a field survey on May 1, 2000 do hereby state that under requirements of P.A. 74, Michigan P.A. of 1970, the corner points mentioned in lines 1 and 2 above were in conformance with regulations and rules therefore as required in the current manual of survey instructions of the United States Department of the Interior, Bureau of Land Management or by a decree of a Court of Law and for that the corner points mentioned in lines 3, 4 and 5 above were in conformance with the rules of the Michigan Board of Land Surveyors or by a Decree of a Court of Law, established, re-established, monumented, recovered, found as expressed below:

NOTE: Not more than 2 corners, all in the same town and range, may be recorded on this certificate.


A	B	C	D	E	F	G	H	I	J	K	L	M
1												
2	6		5		4		3		2		1	
3												
4	7		8		9		10		11		12	
5												
6	18		17		16		15		14		13	
7	●											
8	19		20		21		22		23		24	
9												
10	30		29		28		27		26		25	
11												
12	31		32		33		34		35		36	
13												

A. Description of original monument and accessories and/or subsequent restoration:

GLO Notes  
 Hemlock 18" S63°W 3 Links  
 Hemlock 10" N 3°E 16 Links  
 OLD Survey Liber - None  
 Act 132 - Irvin Chope Liber 1 Page 552, Irvin Chope Liber 1 Page 614  
 Irvin Chope Liber 2 Page 276, Irvin Chope Liber 3 Page 602  
 L.C.R.C. - None

B. Description of corner evidence found and/or method applied in restoring or reestablishing corner:

B - 7  
 S 1/4 Corner Section 18 T12N-R15E  
 Found 1" Iron Bar in gravel road bed  
 West 2606.32 feet to the SW Corner  
 East 2642.54 feet to the SE Corner  
 Accepted as best evidence

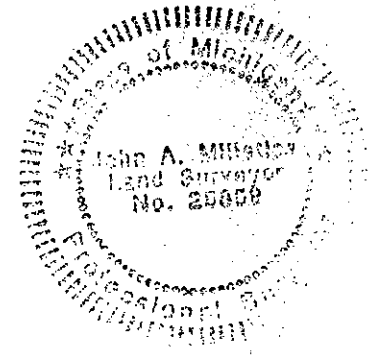

C. Description of monument for corner and accessories established to perpetuate locating the position of the corner:

B - 7  
 S 1/4 Corner Section 18 T12N-R15E  
 1" Iron Bar in Gravel Road Bed  
 South 5'± to centerline of gravel road bed  
 South 28.45 feet to a nail in a Wooden Fence Post  
 N45°W 35.82 feet to a nail in a 24" Ash Tree  
 N45°E 60.10 feet to a nail in a 10" Apple Tree  
 West 2606.32 feet to the SW Corner  
 East 2642.54 feet to the SE Corner

APPROVED PEER BOARD  
 MEETING JUNE 12, 2000

Signed by John A Milletics  
 Surveyor's Michigan License No. 25859

Date June 3, 2000