

SEP 20 2000

2000 REMONUMENTATION PROGRAM
LAND CORNER RECORDATION CERTIFICATE
Filing Requirement of Act 74, Mich. P.A. 1970

RECEIVED FOR RECORD

00 JUN 13 AM 11:58

SECTION

For corners in

<u>Sanilac</u> (County)	Located In:	Corner Code #
1. Public Land Survey	T <u>12</u> NR <u>15</u> E	<u>E - 7</u>
	T ___ R ___	_____
	T ___ R ___	_____
	T ___ R ___	_____
2. Property Controlling in Section	S ___ T ___ R ___	_____
	S ___ T ___ R ___	_____
3. Miscellaneous Property in Sec.	S ___ T ___ R ___	_____
	S ___ T ___ R ___	_____

LIBER NO. 3 PAGE NO. 16
MICHELE VANHORNMAN
REGISTER OF DEEDS
SANILAC CO., MICHIGAN

Register of Deeds Stamp & File Number

4. Lot No. _____, Recorded Plat _____
5. Private Claims _____

I, John A Millettics, in a field survey on May 1 ²⁰⁰⁰ do hereby state that under requirements of P.A. 74, Michigan P.A. of 1970, the corner points mentioned in lines 1 and 2 above were in conformance with regulations and rules therefore as required in the current manual of survey instructions of the United States Department of the Interior, Bureau of Land Management or by a decree of a Court of Law and /or that the corner points mentioned in lines 3, 4 and 5 above were in conformance with the rules of the Michigan Board of Land Surveyors or by a Decree of a Court of Law; established, re-established, monumented, recovered, found as expressed below:

	A	B	C	D	E	F	G	H	I	J	K	L	N
1													
2		6		5		4		3		2		1	
3													
4		7		8		9		10		11		12	
5													
6		18		17		16		15		14		13	
7													
8		19		20		21		22		23		24	
9													
10		30		29		28		27		26		25	
11													
12		31		32		33		34		35		36	
13													

NOTE: Not more than 2 corners, all in the same town and range, may be recorded on this certificate.

A. Description of original monument and accessories and/or subsequent restoration:

GLO Notes

Hemlock 12" N12°E 21 Links

Beech 10" S30°W 11 Links

L.C.R.C Form - None

Act 132 - Sanilac Land Survey Liber 3 Page 768,

Sanilac Land Survey Liber 3 Page 779

OLD Survey Liber - None

B. Description of corner evidence found and/or method applied in restoring or reestablishing corner:

E - 7


SW Corner Section 16 T12N-R15E

Found 1/2" Iron Bar in Gravel Road Bed

West 2626.20 feet to the S 1/4 Corner

East 2644.94 feet to the S 1/4 Corner

Accepted as best evidence

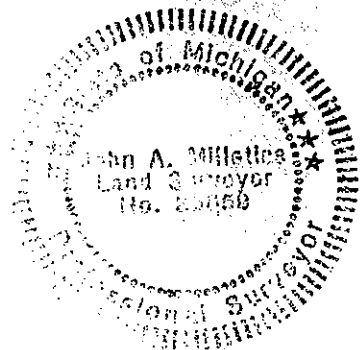

C. Description of monument for corner and accessories established to perpetuate locating the position of the corner:

E - 7

SW Corner Section 17 T12N-R15E

1/2" Iron Bar in gravel road bed with cap

N35°W 32.52 feet to a Stop Sign

S10°E 52.80 feet to a Stop Sign

S20°W 85.25 feet to a Road Sign

S45°W 56.17 feet to a nail in a Power Pole

South 3'± to the center of the gravel road bed

West 2626.20 feet to the S 1/4 Corner

East 2644.94 feet to the S 1/4 Corner

APPROVED PEER BOARD
MEETING JUNE 12, 2000

Signed by John A. Millettics
Surveyor's Michigan License No. 25859

Date June 3, 2000