

SEP 20 2000

2000 REMONUMENTATION PROGRAM
LAND CORNER RECORDATION CERTIFICATE
Filing Requirement of Act 74, Mich. P.A. 1970

RECEIVED FOR RECORD

00 JUN 13 AM 11:58

SECTION

For corners in

<u>Sanilac</u> (County)	Located In:	Corner Code #
1. Public Land Survey	T12N R15E	G - 7
	T R	
	T R	
	T R	
2. Property Controlling in Section	S T R	
	S T R	
3. Miscellaneous Property in Sec.	S T R	
	S T R	

LIBER NO. 3 PAGE NO. 18
MICHELE VANHORMAN
REGISTER OF DEEDS
SANILAC CO., MICHIGAN

Register of Deeds Stamp & File Number

4. Lot No. _____, Recorded Plat _____
5. Private Claims _____

I, John A. Milletics, in a field survey on May 1, 2000 do hereby state that under requirements of P.A. 74, Michigan P.A. of 1970, the corner points mentioned in lines 1 and 2 above were in conformance with regulations and rules therefore as required in the current manual of survey instructions of the United States Department of the Interior, Bureau of Land Management or by a decree of a Court of Law and /or that the corner points mentioned in lines 3, 4 and 5 above were in conformance with the rules of the Michigan Board of Land Surveyors or by a Decree of a Court of Law; established, re-established, monumented, recovered, found as expressed below:

NOTE: Not more than 2 corners, all in the same town and range, may be recorded on this certificate.

A	B	C	D	E	F	G	H	I	J	K	L	M
1												
2	6	5	4	3	2	1						
3												
4	7	8	9	10	11	12						
5												
6	18	17	16	15	14	13						
7												
8	19	20	21	22	23	24						
9												
10	30	29	28	27	26	25						
11												
12	31	32	33	34	35	36						
13												

A. Description of original monument and accessories and/or subsequent restoration:

GLO Notes


Pine 20" N85°E 22 Links
Hemlock 12" N62°W 18 Links

Act 132 - Irvin Choep Liber 1 Page 607, Irvin Choep Liber 3 Page 266
L.C.R.C. - None

B. Description of corner evidence found and/or method applied in restoring or reestablishing corner:

G - 7

SW Corner Section 15 T12N-R15E
Found 1/2" Iron Bar in Gravel Road Bed
West 2643.84 feet to the S 1/4 Corner
East 2656.28 feet to the S 1/4 Corner
Accepted as best evidence

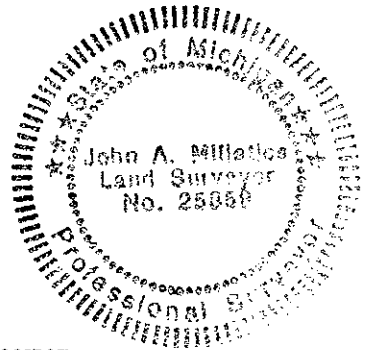

C. Description of monument for corner and accessories established to perpetuate locating the position of the corner:

G - 7

SW Corner Section 15 T12N-R15E
1/2" Iron Bar in Gravel Road Bed
N20°W 38.70 feet to a Stop Sign
N30°E 38.65 feet to the SW Corner of a Riser Box
N35°E 37.50 feet to the SW Corner of a Riser Box
S50°E 64.80 feet to the nail in a Power Pole
S30°E 72.06 feet to the NW Corner of a Riser Box
West 6'± to the centerline of the gravel road
West 2643.84 feet to the S 1/4 Corner
East 2656.28 feet to the S 1/4 Corner

APPROVED PEER BOARD
MEETING JUNE 12, 2000

gm

Signed by John A. Milletics
Surveyor's Michigan License No. 25859

Date June 3, 2000