

SEP 20 2000

2000 REMONUMENTATION PROGRAM LAND CORNER RECORDATION CERTIFICATE Filing Requirement of Act 74, Mich. P.A. 1970

RECEIVED FOR RECORD

00 JUN 13 AM 11:58

LIBER NO. 3 PAGE NO. 20 MICHELE VANORMAN REGISTER OF DEEDS SANILAC CO., MICHIGAN

For corners in SECTION

Sanilac (County)	Located In:	Corner Code #
1. Public Land Survey	T12N R15E	I - 7
	T R	
	T R	
	T R	
2. Property Controlling in Section	S T R	
	S T R	
3. Miscellaneous Property in Sec.	S T R	
	S T R	

Register of Deeds Stamp & File Number

4. Lot No. , Recorded Plat  
5. Private Claims

I, John A Milletics, in a field survey on May 1, 2000 do hereby state that under requirements of P.A. 74, Michigan P.A. of 1970, the corner points mentioned in lines 1 and 2 above were in conformance with regulations and rules therefore as required in the current manual of survey instructions of the United States Department of the Interior, Bureau of Land Management or by a decree of a Court of Law and for that the corner points mentioned in lines 3, 4 and 5 above were in conformance with the rules of the Michigan Board of Land Surveyors or by a Decree of a Court of Law, established, re-established, monumented, recovered, found as expressed below:

NOTE: Not more than 2 corners, all in the same town and range, may be recorded on this certificate.

	A	B	C	D	E	F	G	H	I	J	K	L	M
1													
2	6		5		4		3		2		1		
3													
4	7		8		9		10		11		12		
5													
6	18		17		16		15		14		13		
7													
8	19		20		21		22		23		24		
9													
10	30		29		28		27		26		25		
11													
12	31		32		33		34		35		36		
13													


A. Description of original monument and accessories and/or subsequent restoration:

GLO Notes

- Hemlock 10" SS2°E 5 Links
- Sugar 8" N46°W 20 Links
- Act 132 - Irvin Chope Liber 3 Page 266
- Unrecorded Survey - Milletics Nov 1999, Milletics Aug 1990
- L.C.R.C. - None

B. Description of corner evidence found and/or method applied in restoring or reestablishing corner:

- I - 7
- SW Corner Section 14 T12N-R15E
- Found 5/8" Iron Bar in Monu. Box
- West 2656.28 feet to the S 1/4 Corner
- East 2632.50 feet to the S 1/4 Corner
- Accepted as best evidence

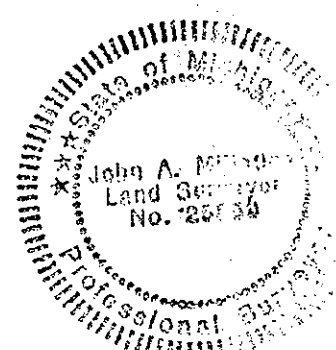

C. Description of monument for corner and accessories established to perpetuate locating the position of the corner:

- I - 7
- SW Corner Section 14 T12N-R15E
- 5/8" Iron Bar in Monu Box
- N60°E 31.44 feet to a Stop Sign
- S60°E 75.62 feet to a nail in a Power Pole
- N50°W 70.08 feet to a nail in a 30" Twin Ash Tree
- S45°W 45.67 feet to a Stop Sign
- S60°W 70.15 feet to a nail in a 30" Ash Tree
- West 2656.28 feet to the S 1/4 Corner
- East 2632.50 feet to the S 1/4 Corner

APPROVED PEER BOARD MEETING JUNE 12, 2000

97

June 1, 2000

Signed by John A. Milletics Surveyor's Michigan License No. 25859

Date