

SEP 20 2000

LIBER 3 PAGE 21

RECEIVED FOR RECORD

00 JUN 13 AM 11:58

2000 REMONUMENTATION PROGRAM  
LAND CORNER RECORDATION CERTIFICATE  
Filing Requirement of Act 74, Mich. P.A. 1970

LIBER NO. 3 PAGE NO. 21  
MICHELE VANNORMAN  
REGISTER OF DEEDS  
SANILAC CO. MICHIGAN

For corners in SECTION

Sanilac (County)	Located In:	Corner Code #
1. Public Land Survey	T12N R15E	J - 7
	T___ R___	_____
	T___ R___	_____
	T___ R___	_____
2. Property Controlling in Section	S___ T___ R___	_____
	S___ T___ R___	_____
3. Miscellaneous Property in Sec.	S___ T___ R___	_____
	S___ T___ R___	_____

Register of Deeds Stamp & File Number

4. Lot No. \_\_\_\_\_, Recorded Plat \_\_\_\_\_  
5. Private Claims \_\_\_\_\_

2000

I, John A Milletics, in a field survey on May 1, 2000 do hereby state that under requirements of P.A. 74, Michigan P.A. of 1970, the corner points mentioned in lines 1 and 2 above were in conformance with regulations and rules therefore as required in the current manual of survey instructions of the United States Department of the Interior, Bureau of Land Management or by a decree of a Court of Law and /or that the corner points mentioned in lines 3, 4 and 5 above were in conformance with the rules of the Michigan Board of Land Surveyors or by a Decree of a Court of Law; established, re-established, monumented, recovered, found as expressed below:

NOTE: Not more than 2 corners, all in the same town and range, may be recorded on this certificate.


	A	B	C	D	E	F	G	H	I	J	K	L	M
1													
2	6		5		4		3		2		1		
3													
4	7		8		9		10		11		12		
5													
6	18		17		16		15		14		13		
7													
8	19		20		21		22		23		24		
9													
10	30		29		28		27		26		25		
11													
12	31		32		33		34		35		36		
13													

A. Description of original monument and accessories and/or subsequent restoration:

GLO Notes  
Ironwood 9" N80°E 15 Links  
Beech 12" S80°W 10 Links  
Act 132 - None  
Unrecorded Survey - Milletics Aug 1990  
L.C.R.C. - None

B. Description of corner evidence found and/or method applied in restoring or reestablishing corner:

J - 7  
S 1/4 Corner Section 14 T12N-R15E  
Found 1/2" Iron Bar in Gravel Road Bed  
West 2632.50 feet to the SW Corner Section 14  
East 2646.12 feet to the SE Corner Section 14  
Accepted as best evidence

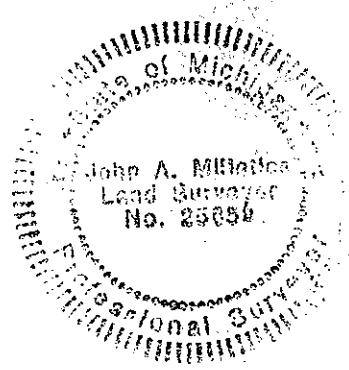

C. Description of monument for corner and accessories established to perpetuate locating the position of the corner:

J - 7  
S 1/4 Corner Section 14 T12N-R15E  
1/2" Iron Bar in gravel road bed with cap  
S05°E 60.70 feet to a nail in a Power Pole  
North 3'± feet to the centerline of the gravel road bed  
N10°E 90.05 feet to a nail in a 18" Apple  
N45°E 89.78 feet to a nail in a 18" Apple  
West 2632.50 feet to the SW Corner Section 14  
East 2646.12 feet to the SE Corner Section 14

APPROVED PEER BOARD  
MEETING JUNE 12, 2000

*gm*

Signed by John A Milletics  
Surveyor's Michigan License No. 25859

Date June 3, 2000