

SEP 20 2000

LIBER 3 PAGE 23

RECEIVED FOR RECORD

00 JUN 13 AM 11:58

SECTION

2000 REMONUMENTATION PROGRAM
LAND CORNER RECORDATION CERTIFICATE
Filing Requirement of Act 74, Mich. P.A. 1970

LIBER NO. 3 PAGE 23
MICHELE VANNORMAN
REGISTER OF DEEDS
SANILAC CO., MICHIGAN

For corners in

Sanilac

(County)

Located In:

Corner Code #

1. Public Land Survey	T12N R15E	L - 7
	T R	
	T R	
	T R	
2. Property Controlling in Section	S T R	
	S T R	
3. Miscellaneous Property in Sec.	S T R	
	S T R	

Register of Deeds Stamp & File Number

4. Lot No. _____, Recorded Plat _____
5. Private Claims _____

2000

I, John A Milletics in a field survey on May 1, 1998 do hereby state that under requirements of P.A. 74, Michigan P.A. of 1970, the corner points mentioned in lines 1 and 2 above were in conformance with regulations and rules therefore as required in the current manual of survey instructions of the United States Department of the Interior, Bureau of Land Management or by a decree of a Court of Law and /or that the corner points mentioned in lines 3, 4 and 5 above were in conformance with the rules of the Michigan Board of Land Surveyors or by a Decree of a Court of Law; established, re-established, monumented, recovered, found as expressed below:

1	A	B	C	D	E	F	G	H	I	J	K	L	M
2		6		5		4		3		2		1	
3													
4		7		8		9		10		11		12	
5													
6		10		17		16		15		14		13	
7													
8		19		20		21		22		23		24	
9													
10		30		29		28		27		26		25	
11													
12		31		32		33		34		35		36	
13													

NOTE: Not more than 2 corners, all in the same town and range, may be recorded on this certificate.

A. Description of original monument and accessories and/or subsequent restoration:

GLO Notes

Beech 9" N89°W 18 Links

Hemlock 10" S06°E 24 Links

Act 132 - Irvin Chope Liber 3 Page 171

L.C.R.C. Forms - None

Unrecorded Surveys - Milletics Oct 1990, Milletics April 1991
Milletics May 1993, Milletics Oct 1998

B. Description of corner evidence found and/or method applied in restoring or reestablishing corner:

L - 7


S 1/4 Corner Section 13 T12N-R15E

Found 1/2" Iron Bar in gravel Road Bed

West 2628.00 feet to the SW Corner Section 13

East 2665.68 feet to the SE Corner Section 13

Accepted as best evidence

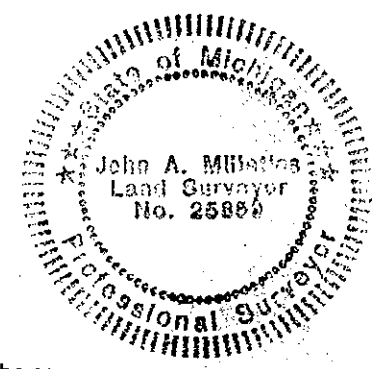

C. Description of monument for corner and accessories established to perpetuate locating the position of the corner:

L - 7

S 1/4 Corner Section 13 T12N-R15E

1/2" Iron bar in gravel road bed with cap

North 13.00 feet to the centerline of gravel road bed

North 33.00 feet to a 1/2" iron bar with cap

South 33.00 feet to a 1/2" iron bar with cap

S60°W 52.30 feet to a nail in a 18" Ash Tree

N30°W 53.87 feet to a nail in a 18" Ash Tree

S45°E 34.70 feet to a nail in a 18" Ash Tree

West 2628.00 feet to the SW Corner

East 2665.68 feet to the SE Corner

APPROVED PEER BOARD
MEETING JUNE 12, 2000

Signed by John A. Milletics

Date June 3, 2000

Surveyor's Michigan License No. 25859