

JAN 19 2000

LIBER 2 PAGE 347

RECEIVED FOR RECORD

SECTION

1999 REMONUMENTATION PROGRAM
LAND CORNER RECORDATION CERTIFICATE
Filing Requirement of Act 74, Mich. P.A. 1970

99 NOV 30 AM 9:04

For corners in

LIBER NO. 2 PAGE NO. 347
MICHELE VANNORMAN
REGISTER OF DEEDS
SANILAC CO., MICHIGAN

<u>SANILAC</u> (County)	Located In:	Corner Code #
1. Public Land Survey	T <u>12NR</u> R <u>16E</u>	<u>A-4</u>
	T ___ R ___	_____
	T ___ R ___	_____
	T ___ R ___	_____
2. Property Controlling in Section	S ___ T ___ R ___	_____
	S ___ T ___ R ___	_____
3. Miscellaneous Property in Sec.	S ___ T ___ R ___	_____
	S ___ T ___ R ___	_____

Register of Deeds Stamp & File Number

4. Lot No. _____, Recorded Plat _____
5. Private Claims _____

I, John A. Milletics, in a field survey on Aug. 2, 1999 do hereby state that under requirements of P.A. 74, Michigan P.A. of 1970, the corner points mentioned in lines 1 and 2 above were in conformance with regulations and rules therefore as required in the current manual of survey instructions of the United States Department of the Interior, Bureau of Land Management or by a decree of a Court of Law and /or that the corner points mentioned in lines 3, 4 and 5 above were in conformance with the rules of the Michigan Board of Land Surveyors or by a Decree of a Court of Law; established, re-established, monumented, recovered, found as expressed below:

NOTE: Not more than 2 corners, all in the same town and range, may be recorded on this certificate.

A	B	C	D	E	F	G	H	I	J	K	L	M
1												
2	6		5		4		3		2		1	
3												
4	7		8		9		10		11		12	
5												
6	18		17		16		15		14		13	
7												
8	19		20		21		22		23		24	
9												
10	30		29		28		27		26		25	
11												
12	31		32		33		34		35		36	
13												

A. Description of original monument and accessories and/or subsequent restoration:

A-4 Beech 16 N22W 20; Beech 9 S21W 28
Old Survey Liber - None
Act 132 - Liber 3 Page 39
L.C.R.C. - None
Unrecorded survey - Chope Dated Oct 1972


B. Description of corner evidence found and/or method applied in restoring or reestablishing corner:

A-4
W 1/4 Corner Section 7, T12N-R16E
Found 1/2" Iron bar in gravel road bed
North 2653.30 feet to the NW Corner Section 7
South 2648.00 feet to the SW Corner Section 7
Accepted as best evidence

APPROVED PEER BOARD MEETING
NOV 19, 1999

C. Description of monument for corner and accessories established to perpetuate locating the position of the corner:

A - 4
W 1/4 Corner Section 7 T12N-R16E
1/2" Iron Bar in gravel Road Bed with cap
North 2653.30 feet to the NW Corner
South 2648.00 feet to the SW Corner
S85°W 27.36 feet to a nail in Fence Post
N45°E 45.96 feet to a nail in a 36" Maple
S45°E 99.59 feet to the NW Corner of a Bell Riser Box
S50°E 100.15 feet to a nail in a Power Pole

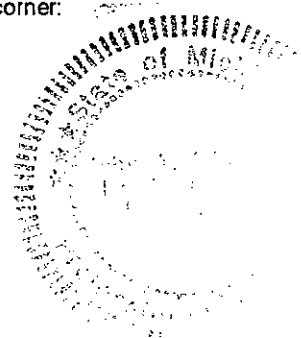

Signed by [Signature] Date 11-15-1999
Surveyor's Michigan License No. 25859