

JAN 22 2001

LIBER 3 PAGE 44

RECEIVED FOR RECORD

SECTION

2000 Remonumentation Program  
LAND CORNER RECORDATION CERTIFICATE  
Filing Requirement of Act 74, Mich. P.A. 1970

00 NOV 27 AM 8:56

LIBER NO. 3 PAGE NO. 44  
MICHELE VANNORMAN  
REGISTER OF DEEDS  
SANILAC CO., MICHIGAN

For corners in

Sanilac

(County)

Located In:

Corner Code #

- 1. Public Land Survey T12N R16E D - 7  
T R  
T R  
T R
- 2. Property Controlling in Section S T R  
S T R
- 3. Miscellaneous Property in Sec. S T R  
S T R

Register of Deeds Stamp & File Number

- 4. Lot No. \_\_\_\_\_, Recorded Plat \_\_\_\_\_
- 5. Private Claims \_\_\_\_\_

2000

I, John A Milletics, in a field survey on May 1, 2000, do hereby state that under requirements of P.A. 74, Michigan P.A. of 1970, the corner points mentioned in lines 1 and 2 above were in conformance with regulations and rules therefore as required in the current manual of survey instructions of the United States Department of the Interior, Bureau of Land Management or by a decree of a Court of Law and/or that the corner points mentioned in lines 3, 4 and 5 above were in conformance with the rules of the Michigan Board of Land Surveyors or by a Decree of a Court of Law, established, re-established, monumented, recovered, found as expressed below:

NOTE: Not more than 2 corners, all in the same town and range, may be recorded on this certificate.

1	A	B	C	D	E	F	G	H	I	J	K	L	M
2		6		5		4		3		2		1	
3													
4		7		8		9		10		11		12	
5													
6		18		17		16		15		14		13	
7													
8		19		20		21		22		23		24	
9													
10		30		29		28		27		26		25	
11													
12		31		32		33		34		35		36	
13													

A. Description of original monument and accessories and/or subsequent restoration:

GLO Notes


- Elm 6" S70°W 8 Links
- Hemlock 18" N89°E 25 Links

Act 132 - Sanilac Land Survey Liber 4 Page 99  
Sanilac Land Survey Liber 4 Page 628

Unrecorded Surveys - Milletics July 1993, Sept 1997, Dec 1998, Sept 1999

B. Description of corner evidence found and/or method applied in restoring or reestablishing corner:

- D - 7
- S 1/4 Corner Section 17 T12N-R16E
- Found 1/2" Iron Bar in Gravel Road Bed
- West 2674.06 feet to the SW Corner
- East 2672.80 feet to the SE Corner
- Accepted as best evidence

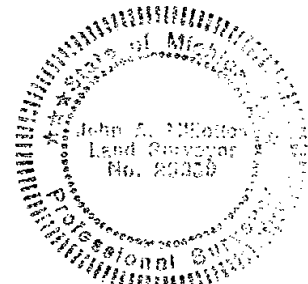

C. Description of monument for corner and accessories established to perpetuate locating the position of the corner:

- D - 7
- S 1/4 Corner Section 17 T12N-R16E
- 1/2" Iron Bar in Gravel Road Bed with cap
- South 5.5'± to the centerline of gravel road bed
- North 33.00 feet to a 1/2" iron bar with cap
- South 33.00 feet to a 1/2" iron bar with cap
- N40°E 24.67 feet to a nail in a 9" Ash
- S45°E 49.40 feet to a nail in a 24" Poplar
- West 2674.06 feet to the SW Corner
- East 2672.80 feet to the SE Corner

APPROVED PEER BOARD  
MEETING NOV 25 2000

*Jm*

Signed by John A Milletics  
Surveyor's Michigan License No. 25859

Date June 6, 2000