

SECTION

LIBER 3 PAGE 63

LAND CORNER RECORDATION CERTIFICATE  
 Filing Requirement of Act 74, Mich. P.A. 1970  
 2000 REMONUMENTATION PROGRAM

RECEIVED FOR RECORD  
 00 NOV 29 AM 11:11  
 LIBER NO. 3 PAGE NO. 63  
 MICHELE VANNORMAN  
 REGISTER OF DEEDS  
 SANILAC CO. MICHIGAN

For corners in

Sanilac (County)	Located In:	Corner Code #
1. Public Land Survey	T12N R16E	D - 13
	T R	
	T R	
	T R	
2. Property Controlling in Section	S T R	
	S T R	
3. Miscellaneous Property in Sec.	S T R	
	S T R	

Register of Deeds Stamp & File Number

4. Lot No. \_\_\_\_\_, Recorded Plat \_\_\_\_\_  
 5. Private Claims \_\_\_\_\_

I, John A. Milletics, in a field survey on May 1, 2000 do hereby state that under requirements of P.A. 74, Michigan P.A. of 1970, the corner points mentioned in lines 1 and 2 above were in conformance with regulations and rules therefore as required in the current manual of survey instructions of the United States Department of the Interior, Bureau of Land Management or by a decree of a Court of Law and /or that the corner points mentioned in lines 3, 4 and 5 above were in conformance with the rules of the Michigan Board of Land Surveyors or by a Decree of a Court of Law, established, re-established, monumented, recovered, found as expressed below:

NOTE: Not more than 2 corners, all in the same town and range, may be recorded on this certificate.

	A	B	C	D	E	F	G	H	I	J	K	L	M
1													
2	6		5		4		3		2		1		
3													
4	7		8		9		10		11		12		
5													
6	18		17		16		15		14		13		
7													
8	19		20		21		22		23		24		
9													
10	30		29		28		27		26		25		
11													
12	31		32		33		34		35		36		
13													

A. Description of original monument and accessories and/or subsequent restoration:

GLO Notes

- Beech 7" N86°W 21 Links
- Beech 10" N75°E 11 Links

Act 132 - None

Unrecorded surveys-Milletics Oct 1993, Milletics Dec 1993, Milletics March 1999

L.C.R.C. - None

Ol Survey Liber - None

B. Description of corner evidence found and/or method applied in restoring or reestablishing corner:

D - 13

S 1/4 Corner Section 32 T12N-R16E

Found no evidence of corner at site, Removed by State Highway Dept during construction

West 2652.15 feet to the SW Corner Section 32

East 2652.15 feet to the SE Corner Section 32

Accepted as best evidence

C. Description of monument for corner and accessories established to perpetuate locating the position of the corner:

D - 13

S 1/4 Corner Section T12N-R16E

1/2" Iron Bar with cap in concrete

West 2.82 feet to the N 1/4 Corner Section 5

N30°W 50.25 feet to a nail in a 24" Maple


N05°E 66.18 feet to a nail in a 24" Maple

N30°E 72.15 feet to a nail in a 24" Maple

West 2652.15 feet to the SW Corner Section 32

East 2652.15 feet to the SE Corner Section 32

APPROVED PEER BOARD  
 MEETING Nov 25, 2000

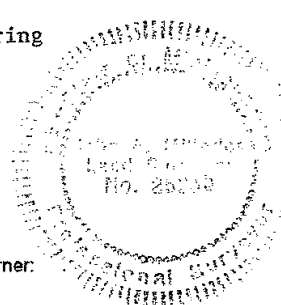

Signed by John A. Milletics  
 Surveyor's Michigan License No. 25859

Date Nov 15, 2000